

SURVEY & REMONUMENTATION

APR 27 1995

KENT COUNTY REMONUMENTATION

STATE OF MICHIGAN
COUNTY OF KENT
RECEIVED FOR RECORD

COMMISSION

LAND CORNER RECORDATION CERTIFICATE

Filing Requirement of Act 74, Mich. P.A. 1970 94 DEC -5 AM 8:57

For corners in
KENT COUNTY

(County)

Located In:

Corner Code #

1. Public Land Survey	T <u>6N</u> R <u>11W</u>	<u>G-4</u>
	T _____ R _____	_____
	T _____ R _____	_____
	T _____ R _____	_____
2. Property Controlling in Section	S _____ T _____ R _____	_____
	S _____ T _____ R _____	_____
3. Miscellaneous Property in Sec.	S _____ T _____ R _____	_____
	S _____ T _____ R _____	_____

Luigi J. Bond
REG. OF DEEDS

7655

Register of Deeds Stamp & File Number

4. Lot No. _____, Recorded Plat _____
5. Private Claims _____

	A	B	C	D	E	F	G	H	I	J	K	L	M
2	6	5	4	3	2	1							
3													
4	7	8	9	10	11	12							
5													
6	18	17	16	15	14	13							
7													
8	19	20	21	22	23	24							
9													
10	30	29	28	27	26	25							
11													
12	31	32	33	34	35	36							
13													

I, William R. Byl, in a field survey on Sept. 22, 19 94, do hereby certify that under requirements of P.A. 74, Michigan P.A. of 1970, the corner points mentioned in lines 1 and 2 above were in conformance with regulations and rules therefore as required in the current manual of survey instructions of the United States Department of the Interior, Bureau of Land Management or by a decree of a Court of Law and/or that the corner points mentioned in lines 3, 4 and 5 above were in conformance with the rules of the Michigan Board of Land Surveyors or by a Decree of a Court of Law; established, re-established, monumented, re-monumented, recovered, found as expressed below:

NOTE: Not more than 4 corners, all in the same town and range, may be recorded on this certificate.

A. Description of original monument and accessories and/or subsequent restoration:

G-4	1831	GLO	Mullett	Set Post	P.A. 345 1990 KENT COUNTY PEER APPROVED <u>12/1/94</u> CHAIRMAN <u>Harry Kisher</u>
	1944	Kent Co. Wit.		Iron	
	1981	LCRC #1610	Bonnema	PK Nail	
	1981	LCRC #2479	Hackbardt	Set Kent County Monument	
	1992	LCRC #6532	Bueche	Reset Kent County Monument	

The position of this corner was previously approved by the Kent County Remonumentation Peer Group, monumented by Glen S. Hackbardt on 9/23/81 and was recorded per LCRC #2479

B. Description of corner evidence found and/or method applied in restoring or reestablishing corner:


G-4 Found standard Kent Co. Mon. (Harrison) per witnesses from above LCRC as set by John C. Bueche in same location as set in 1981 by Glen S. Hackbardt in place of the PK Nail he found. Said PK Nail checks with LCRC #1610 and adjoining plats.

<u>LCRC #2479</u>	Nail & tag 6" Sassafras	S60°W 41.54'	<u>LCRC #6532</u>	Nail & KC tag S. side 8" Elm	S72°W 40.54'
	Nail & tag 12" Sassafras	West 37.51'		Nail & KC tag W. side 18" Oak	N45°E 57.66'
	Nail & tag 12" Sassafras	N40°W 66.10'		Nail & KC tag N. side 24" Elm	N86°E 39.41'
	Nail & tag 12" Oak	N45°E 57.72'		Nail & KC tag NW side 10" Sass.	S60°W 45.51'
	Nail & tag 5" Tree	East 52.59'		NW cor. head of CB	S16°W 75.81'
				NE cor. head of CB	S19°E 79.19'
				C/L bit. rd. N-S is E. 2' m/l	

The selected location is accepted by me and is generally accepted by professional surveyors as the best available evidence of the position of the original corner.

C. Description of monument for corner and accessories established to perpetuate locating the position of the corner:

G-4 Standard Kent County Monument		
Nail & KC Remon. tag S. side 12" Sassfras	S72°W	40.54'
New Nail & KC Remon. tag W. side 18" Oak	N45°E	57.70'
New Nail & KC Remon. tag N. side 24" Elm	N86°E	39.46'
Nail & KC Remon. tag NW side 10" Sassfras	S60°W	45.51'
NW cor. head of CB	S16°W	75.81'
NE cor. head of CB	S19°E	79.19'
Set Nail & KC Remon. tag N. side 24" Maple	N65°W	66.23'
C/L bit. rd. N-S is E. 2' m/l		

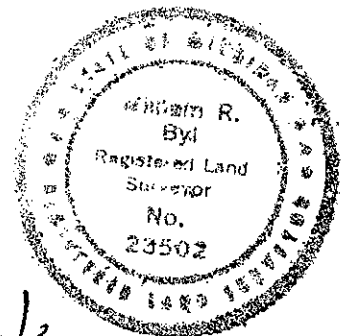

Signed by W. R. Byl
Surveyor's Michigan License No. 23502

Date 11/27/94