

SURVEY & REMONUMENTATION

KENT COUNTY REMONUMENTATION

APR 27 1995

LAND CORNER RECORDATION CERTIFICATE
Filing Requirement of Act 74, Mich. P.A. 1970

STATE OF MICHIGAN
COUNTY OF KENT
RECEIVED FOR RECORD

94 DEC -5 AM 8:58

COMMISSION

For corners in
KENT COUNTY
(County)

Located In: Corner Code #/

- | | | |
|---------------------------------------|--------------------------|-------------|
| 1. Public Land Survey | T <u>6N</u> R <u>11W</u> | <u>G-13</u> |
| | T _____ R _____ | _____ |
| | T _____ R _____ | _____ |
| | T _____ R _____ | _____ |
| 2. Property Controlling in Section | S _____ T _____ R _____ | _____ |
| | S _____ T _____ R _____ | _____ |
| 3. Miscellaneous Property in Sec. | S _____ T _____ R _____ | _____ |
| | S _____ T _____ R _____ | _____ |
| 4. Lot No. _____, Recorded Plat _____ | | |
| 5. Private Claims _____ | | |

Lucy J. Jand
REG. OF DEEDS

7664

Register of Deeds Stamp & File Number

	A	B	C	D	E	F	G	H	I	J	K	L	M
2	6	5	4	3	2	1							
3													
4	7	8	9	10	11	12							
5													
6	18	17	16	15	14	13							
7													
8	19	20	21	22	23	24							
9													
10	30	29	28	27	26	25							
11													
12	31	32	33	34	35	36							
13													

I, William R. Byl, in a field survey on July 7, 19 94, do hereby certify that under requirements of P.A. 74, Michigan P.A. of 1970, the corner points mentioned in lines 1 and 2 above were in conformance with regulations and rules therefore as required in the current manual of survey instructions of the United States Department of the Interior, Bureau of Land Management or by a decree of a Court of Law and/or that the corner points mentioned in lines 3, 4 and 5 above were in conformance with the rules of the Michigan Board of Land Surveyors or by a Decree of a Court of Law; established, re-established, monumented, re-monumented, recovered, found as expressed below:

NOTE: Not more than 4 corners, all in the same town and range, may be recorded on this certificate.

A. Description of original monument and accessories and/or subsequent restoration:

G-13	1831	GLO	Mullett	Set Post
	1943	Kent Co. Wit.		Stone-Iron
	1982	LCRC #3165	Jonker	1 1/2" Iron in mon. box
	1983	LCRC #3388	Stadt	Set Kent County Monument
	1992	LCRC #6541	Bueche	Kent County Monument

P.A. 345 1990 KENT COUNTY

PEER APPROVED 12/1/94

CHAIRMAN *Harry Huber*

The position of this corner was previously approved by the Kent County Remonumentation Peer Group, monumented by Russell E. Stadt on 5/4/83 and was recorded per LCRC #3388

B. Description of corner evidence found and/or method applied in restoring or reestablishing corner:


G-13 Found standard Kent Co. Mon. (Harrison) per witnesses from above LCRC as set by Russell E. Stadt in place of the 1 1/2" Iron he found inside a mon. box. Said 1 1/2" iron checks with Kent Co. Wit. and LCRC #3165

<u>LCRC #3388</u>	<u>LCRC #6541</u>
SE cor. brk. hse. N35°W 102.50'	SE cor. brick gar. hse. #2387 N35°W 102.50'
SE cor. headwall S55°W 39.70'	SE cor. conc. headwall S55°W 39.70'
NE cor. headwall N40°W 42.30'	NE cor. conc. headwall N40°W 42.30'
Nail & tag 8" Elm South 49.50'	Nail & KC tag W. side 14" Elm S05°E 120.13'
Iron in mon. box East 10.34'	SW cor. brick hse. #2387 N55°W 161.24'
On fence line N.; On C/L bit. E-W	KC Mon., NE cor. 4-5-11 East 10.34'
	On C/L bit. E-W; on fence line N.

The selected location is accepted by me and is generally accepted by professional surveyors as the best available evidence of the position of the original corner.

C. Description of monument for corner and accessories established to perpetuate locating the position of the corner:

G-13 Standard Kent County Monument	
SE cor. brick gar. hse. #2387	N35°W 102.55'
SE cor. conc. headwall	S55°W 39.62'
NE cor. conc. headwall	N40°W 42.25'
New Nail & KC Remon. tag W. side 14" Elm	S05°E 120.08'
SW cor. brick hse. #2387	N55°W 161.20'
KC Mon., NE cor. Sec.4, T5N, R11W	S90°E 10.34'
On C/L bit. E-W; on fence line N.	

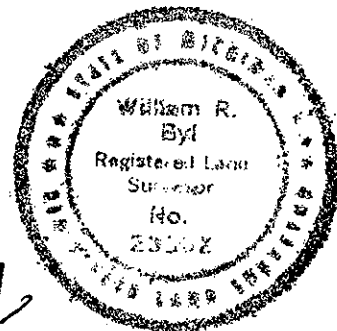

Signed by *William R. Byl*
Surveyor's Michigan License No. 23502

Date 11/27/94