

SURVEY & REMONUMENTATION

APR 27 1995

COMMISSION

For corners in KENT COUNTY

KENT COUNTY REMONUMENTATION

LAND CORNER RECORDATION CERTIFICATE

Filing Requirement of Act 74, Mich. P.A. 1970

STATE OF MICHIGAN
COUNTY OF KENT
RECEIVED FOR RECORD

94 DEC -5 AM 8:58

Lucy Bond
REG. OF DEEDS

Located In:	Corner Code #
1. Public Land Survey T <u>6N</u> R <u>11W</u>	<u>H-1</u>
T _____ R _____	_____
T _____ R _____	_____
T _____ R _____	_____
2. Property Controlling S _____ T _____ R _____	_____
in Section S _____ T _____ R _____	_____
3. Miscellaneous S _____ T _____ R _____	_____
Property in Sec. S _____ T _____ R _____	_____
4. Lot No. _____, Recorded Plat _____	_____
5. Private Claims _____	_____

7665

Register of Deeds Stamp & File Number

	A	B	C	D	E	F	G	H	I	J	K	L	M
2	6	5	4	3	2	1							
3													
4	7	8	9	10	11	12							
5													
6	18	17	16	15	14	13							
7													
8	19	20	21	22	23	24							
9													
10	30	29	28	27	26	25							
11													
12	31	32	33	34	35	36							
13													

I, William R. Byl, in a field survey on July 6, 19 94, do hereby certify that under requirements of P.A. 74, Michigan P.A. of 1970, the corner points mentioned in lines 1 and 2 above were in conformance with regulations and rules therefore as required in the current manual of survey instructions of the United States Department of the Interior, Bureau of Land Management or by a decree of a Court of Law and/or that the corner points mentioned in lines 3, 4 and 5 above were in conformance with the rules of the Michigan Board of Land Surveyors or by a Decree of a Court of Law; established, re-established, monumented, re-monumented, recovered, found as expressed below:

NOTE: Not more than 4 corners, all in the same town and range, may be recorded on this certificate.

A. Description of original monument and accessories and/or subsequent restoration:

H-1	1831	GLO	Not Set
	1924-40	Williams & Works	Iron
	1959	Kent Co. Wit.	Monument
		City of E. Grand Rapids	Iron
	1985	LCRC #4261	Set Kent County Monument
	1991	LCRC #6378	Kent County Monument

P.A. 345 1990 KENT COUNTY
PEER APPROVED 12/11/94
CHAIRMAN *Harry Huber*

The position of this corner was previously approved by the Kent County Remonumentation Peer Group, monumented by William R. Byl on 5/13/85 and was recorded per LCRC #4261

B. Description of corner evidence found and/or method applied in restoring or reestablishing corner:


H-1 Found standard Kent Co. Mon. (Harrison) per witnesses from above LCRC as set by William R. Byl. Said location was set from adjoining plat monuments and irons, as corner and witnesses (as well as H-13, T7N, R11W) have been removed during construction over the years.

LCRC #4261		LCRC #6378	
SW cor. MBT cabinet	N50°E 31.34'	Nail & tag SW sd. 12" Sycamore	N65°W 24.20'
Face of hydr. jacket	S50°W 45.28'	SE corner steel MBT cabinet	N38°E 31.86'
Face of curb	N00°E 6.54'	Nail & tag S. side Util. Pole	N72°E 110.25'
NE cor. brk. hse.	S20°W 82.47'	Nail & tag W. side 16" Elm	S50°E 67.57'
Nail & tag 24" Maple	S15°E 54.33'	Nail & tag E. side 28" Maple	S21°E 54.39'
KC Mon. S 1/4, 34-7-11	N90°E 26.08'	Top C/L nut hydrant	S38°W 45.53'
		KC Mon. at S 1/4 cor. Sec. 34	N90°E 26.12'

The selected location is accepted by me and is generally accepted by professional surveyors as the best available evidence of the position of the corner.

C. Description of monument for corner and accessories established to perpetuate locating the position of the corner:

H-1 Standard Kent County Monument			
New Nail & KC Remon. tag SW sd. 14" Sycamore	N65°W	24.20'	
SE corner steel MBT cabinet	N38°E	31.86'	
Nail & KC Remon. tag S. side Util. Pole	N72°E	110.27'	
New Nail & KC Remon. tag W. side 18" Elm	S50°E	67.54'	
Nail & KC Remon. tag E. side 30" Maple	S21°E	54.42'	
Top C/L nut hydrant	S38°W	45.57'	
KC Mon. at S 1/4 cor. Sec. 34, T7N, R11W	N90°E	26.12'	

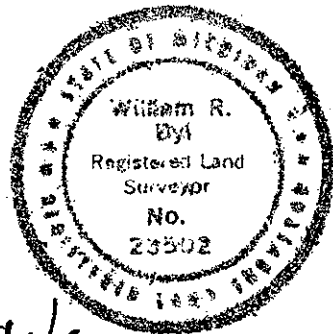

Signed by *W. R. Byl*
Surveyor's Michigan License No. 23502

Date 11/27/94