

JAN 24 1996

KENT COUNTY REMONUMENTATION

\$7.00  
\$2.00

COMMISSION LAND CORNER RECORDATION CERTIFICATE  
Filing Requirement of Act 74, Mich. P.A. 1970

For corners in  
KENT COUNTY  
(County)

Located In:

Corner Code #

1. Public Land Survey	T	<u>6N</u>	R	<u>11W</u>	<u>H-2</u>
	T	_____	R	_____	_____
	T	_____	R	_____	_____
	T	_____	R	_____	_____
2. Property Controlling in Section	S	_____	T	_____	R
	S	_____	T	_____	R
3. Miscellaneous Property in Section	S	_____	T	_____	R
	S	_____	T	_____	R

REG. OF DEEDS

*Lucy Bond*

95 DEC 20 AM 8:38

STATE OF MICHIGAN  
COUNTY OF KENT  
RECEIVED FOR RECORD

8797

Register of Deeds Stamp & File Number

- 4. Lot No. \_\_\_\_\_, Recorded Plat \_\_\_\_\_
- 5. Private Claims \_\_\_\_\_

A	B	C	D	E	F	G	H	I	J	K	L	M
2	6	5	4	3	2	1						
3												
4	7	8	9	10	11	12						
5												
6	18	17	16	15	14	13						
7												
8	19	20	21	22	23	24						
9												
10	30	29	28	27	26	25						
11												
12	31	32	33	34	35	36						
13												

I, Kirk Breitels, in a field survey on Nov. 17, 1994, do hereby certify that under requirements of P.A. 74, Michigan P.A. of 1970, the corner points mentioned in lines 1 and 2 above were in conformance with regulations and rules therefore as required in the current manual of survey instructions of the United States Department of the Interior, Bureau of Land Management or by a decree of a Court of Law and/or that the corner points mentioned in lines 3, 4 and 5 above were in conformance with the rules of the Michigan Board of Professional Surveyors or by a Decree of a Court of Law; established, re-established, monumented, re-monumented, recovered, found as expressed below:

NOTE: Not more than 4 corners, all in the same town and range, may be recorded on this certificate.

A. Description of original monument and accessories and/or subsequent restoration:

H-2	1831	GLO	Not Set
	1924	Williams & Works	Fence Post
		Kent Co. Wit.	Iron

B. Description of corner evidence found and/or method applied in restoring or reestablishing corner:

H-2 Found "T" Iron that fits adjoining plats and measurements of others. Said "T" Iron is 6.6' N. & 1.1' E. from intersection of true 1/4 lines.

The "T" Iron is accepted by me and is generally accepted by professional surveyors as the best available evidence of the position of the corner.

P.A. 345 1990 KENT COUNTY

PEER APPROVED  
PEER APPROVED

11/17/94


CHAIRMAN

*[Signature]*

C. Description of monument for corner and accessories established to perpetuate locating the position of the corner:

H-2 Set Standard Kent County Monument over top of the "T" Iron (in concrete)

Set Nail & KC Remon. tag W. side P. Pole	S05°E	1.23'
SE corner house foundation	N60°W	33.07'
SE corner brick patio wall	N20°W	43.92'
SW corner house foundation (stucco)	N65°E	60.38'

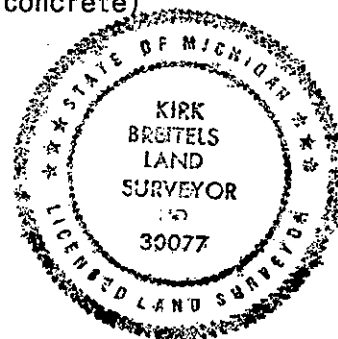

Signed by

*[Signature]*

Date

12/11/95

Surveyor's Michigan License No. 30077