

SURVEY & REMONUMENTATION

APR 27 1995

KENT COUNTY REMONUMENTATION

COMMISSION

LAND CORNER RECORDATION CERTIFICATE
Filing Requirement of Act 74, Mich. P.A. 1970

STATE OF MICHIGAN
COUNTY OF KENT
RECEIVED FOR RECORD

94 DEC -5 AM 8:58

REG. OF DEEDS

7666

Register of Deeds Stamp & File Number

For corners in
KENT COUNTY

(County)

Located In:

Corner Code #

- | | | | | | |
|------------------------------------|---|-----------|---|------------|------------|
| 1. Public Land Survey | T | <u>6N</u> | R | <u>11W</u> | <u>H-5</u> |
| | T | | R | | |
| | T | | R | | |
| | T | | R | | |
| 2. Property Controlling in Section | S | | T | R | |
| | S | | T | R | |
| 3. Miscellaneous Property in Sec. | S | | T | R | |
| | S | | T | R | |

4. Lot No. _____, Recorded Plat _____
5. Private Claims _____

I, William R. Byl, in a field survey on Sept. 14, 1994, do hereby certify that under requirements of P.A. 74, Michigan P.A. of 1970, the corner points mentioned in lines 1 and 2 above were in conformance with regulations and rules therefore as required in the current manual of survey instructions of the United States Department of the Interior, Bureau of Land Management or by a decree of a Court of Law and/or that the corner points mentioned in lines 3, 4 and 5 above were in conformance with the rules of the Michigan Board of Land Surveyors or by a Decree of a Court of Law; established, re-established, monumented, re-monumented, recovered, found as expressed below:

NOTE: Not more than 4 corners, all in the same town and range, may be recorded on this certificate.

A. Description of original monument and accessories and/or subsequent restoration:

H-5	1831	GLO	Mullett	Set Post
	1972	LCRC #272	VanKooten	Iron in mon. box
	1981	LCRC #2031	Hackbardt	Set Kent County Monument in mon. box

P.A. 345 1990 KENT COUNTY

PEER APPROVED 12/1/94
CHAIRMAN Harry Huber

The position of this corner was previously approved by the Kent County Remonumentation Peer Group, monumented by Glen S. Hackbardt on 6/11/81 and was recorded per LCRC #2031

B. Description of corner evidence found and/or method applied in restoring or reestablishing corner:

H-5 Found standard Kent Co. Mon. (Harrison) in a mon. box per witnesses from above LCRC as set by Glen S. Hackbardt in place of the 5/8" x 12" Iron he found inside a mon. box. Said Iron in mon. box checks with LCRC #272 and survey data by others.


LCRC #2031

SW cor. brick bldg.	N05°E	124.9'
NE cor. CB header	N60°W	48.20'
SE cor. CB	S45°W	53.59'
C/L of manhole	S40°W	59.47'
Face of 15" dia. conc. base to light pole	South	60.38'

The selected location is accepted by me and is generally accepted by professional surveyors as the best available evidence of the position of the original corner.

C. Description of monument for corner and accessories established to perpetuate locating the position of the corner:

H-5 Standard Kent County Monument in mon. box		
NE cor. CB header	N60°W	48.17'
SE cor. CB	S45°W	53.50'
C/L of manhole	S40°W	59.47'
Face of 15" dia. conc. base to light pole	S00°W	60.33'
SW'ly face 12" dia. sing post	N45°E	107.68'
Set Nail & KC Remon. tag W. side P. Pole	N30°W	103.99'

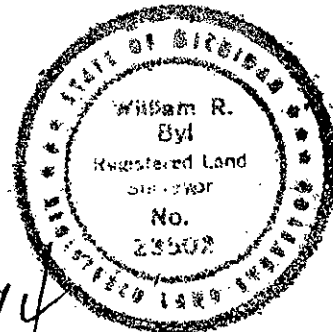

Signed by William R. Byl
Surveyor's Michigan License No. 23502

Date 11/27/94