

SURVEY & REMONUMENTATION

APR 27 1995

KENT COUNTY REMONUMENTATION

STATE OF MICHIGAN
COUNTY OF KENT
RECEIVED FOR RECORD

COMMISSION

LAND CORNER RECORDATION CERTIFICATE
Filing Requirement of Act 74, Mich. P.A. 1970

94 DEC -5 AM 8:58

For corners in
KENT COUNTY

(County)	Located In:	Corner Code #
1. Public Land Survey	T <u>6N</u> R <u>11W</u>	<u>I-1</u>
	T _____ R _____	_____
	T _____ R _____	_____
	T _____ R _____	_____
2. Property Controlling in Section	S _____ T _____ R _____	_____
	S _____ T _____ R _____	_____
3. Miscellaneous Property in Sec.	S _____ T _____ R _____	_____
	S _____ T _____ R _____	_____

W. J. Bond
REG. OF DEEDS

7671

Register of Deeds Stamp & File Number

4. Lot No. _____, Recorded Plat _____
5. Private Claims _____

	A	B	C	D	E	F	G	H	I	J	K	L	M
2	6	5	4	3	2	1							
3													
4	7	8	9	10	11	12							
5													
6	18	17	16	15	14	13							
7													
8	19	20	21	22	23	24							
9													
10	30	29	28	27	26	25							
11													
12	31	32	33	34	35	36							
13													

I, William R. Byl, in a field survey on July 7, 19 94, do hereby certify that under requirements of P.A. 74, Michigan P.A. of 1970, the corner points mentioned in lines 1 and 2 above were in conformance with regulations and rules therefore as required in the current manual of survey instructions of the United States Department of the Interior, Bureau of Land Management or by a decree of a Court of Law and/or that the corner points mentioned in lines 3, 4 and 5 above were in conformance with the rules of the Michigan Board of Land Surveyors or by a Decree of a Court of Law; established, re-established, monumented, re-monumented, recovered, found as expressed below:

NOTE: Not more than 4 corners, all in the same town and range, may be recorded on this certificate.

A. Description of original monument and accessories and/or subsequent restoration:

I-1	1831	GLO	Mullett	Set Post
		Kent Co. Wit.		Iron
	1972	LCRC #298	N.C. Jones	1/2" ID Iron
	1980	LCRC #1436	Merzinski	Set Kent County Monument
	1992	LCRC #6377	Marschall	Kent County Monument

P.A. 845 1980 KENT COUNTY

PEER APPROVED
CHAIRMAN

12/1/94
Harry Huber

The position of this corner was previously approved by the Kent County Remonumentation Peer Group, monumented by John A. Merdzinski on 10/21/80 and was recorded per LCRC #1436

B. Description of corner evidence found and/or method applied in restoring or reestablishing corner:


I-1 Found standard Kent Co. Mon. (Harrison) per witnesses from above LCRC as set by John A. Merdzinski in place of the 1/2" Iron Pipe he found. Said Iron Pipe checks with Kent Co. Wit. & LCRC #298.

LCRC #1436		LCRC #6377	
Nail & tag P. Pole	N50°W 53.98'	Nail & tag S. side P. Pole	N51°W 53.92'
SW cor. hse. fnd.	N30°E 58.90'	C/L top nut hydrant	S72°W 94.17'
NE cor. blk. fnd.	S10°W 80.52'	Nail & tag S. sd. Tri. 10" Maple	N73°W 122.75'
Fire Hydrant	S70°W 94.25'	Nail & tag E. side Util. Pole	S01°W 30.15'
Nail & tag Tri. 8" Maple	N75°W 122.82'		
Nail & tag P. Pole	East 98.29'		
C/L Hall St. W. at E. end of conc. pvt.			

The selected location is accepted by me and is generally accepted by professional surveyors as the best available evidence of the position of the original corner.

C. Description of monument for corner and accessories established to perpetuate locating the position of the corner:

I-1 Standard Kent County Monument		
Nail & KC Remon. tag S. side P. Pole	N51°W	53.95'
C/L top nut hydrant	S72°W	94.19'
New Nail & KC Remon. tag S. sd. Tri. 10" Maple	N73°W	122.83'
Nail & KC Remon. tag E. side Util. Pole	S01°W	30.19'
Set Nail & KC Remon. tag NE side 16" Oak	S40°E	80.50'
C/L Hall St. W. at E. end of conc. pvt. with bit. cap		

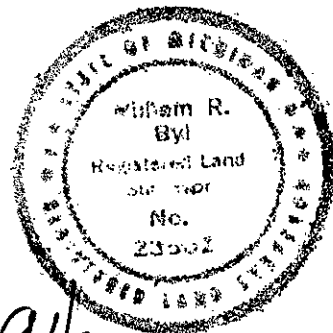

Signed by *W. R. Byl*
Surveyor's Michigan License No. 23502

Date 11/27/94