

**SURVEY & REMONUMENTATION**

APR 27 1995

**COMMISSION**

KENT COUNTY REMONUMENTATION

**LAND CORNER RECORDATION CERTIFICATE**  
Filing Requirement of Act 74, Mich. P.A. 1970

STATE OF MICHIGAN  
COUNTY OF KENT  
RECEIVED FOR RECORD  
94 DEC -5 AM 8:58

*Lucy J. Bond*  
REG. OF DEEDS

For corners in  
**KENT COUNTY**  
(County)

Located In:	Corner Code #
T <u>6N</u> R <u>11W</u>	<u>I-4</u>
T _____ R _____	_____
T _____ R _____	_____
T _____ R _____	_____
T _____ R _____	_____
S _____ T _____ R _____	_____
S _____ T _____ R _____	_____
S _____ T _____ R _____	_____
S _____ T _____ R _____	_____

**7674**

Register of Deeds Stamp & File Number

4. Lot No. \_\_\_\_\_, Recorded Plat \_\_\_\_\_  
5. Private Claims \_\_\_\_\_

	A	B	C	D	E	F	G	H	I	J	K	L	M
2	6	5	4	3	2	1							
3													
4	7	8	9	10	11	12							
5													
6	18	17	16	15	14	13							
7													
8	19	20	21	22	23	24							
9													
10	30	29	28	27	26	25							
11													
12	31	32	33	34	35	36							
13													

I, William R. Byl, in a field survey on Sept. 20, 19 94, do hereby certify that under requirements of P.A. 74, Michigan P.A. of 1970, the corner points mentioned in lines 1 and 2 above were in conformance with regulations and rules therefore as required in the current manual of survey instructions of the United States Department of the Interior, Bureau of Land Management or by a decree of a Court of Law and/or that the corner points mentioned in lines 3, 4 and 5 above were in conformance with the rules of the Michigan Board of Land Surveyors or by a Decree of a Court of Law; established, re-established, monumented, re-monumented, recovered, found as expressed below:

**NOTE: Not more than 4 corners, all in the same town and range, may be recorded on this certificate.**

A. Description of original monument and accessories and/or subsequent restoration:

I-4	1831	GLO	Mullett	Set Post
	1966	Kent Co. Wit.		Iron
	1972	LCRC #301	N.C. Jones	1/2" ID Iron
	1980	LCRC #1431	Merdzinski	Set Kent County Monument
	1989	LCRC #4948	Bueche	Kent County Monument

P.A. 345 1990 KENT COUNTY  
PEER APPROVED 12/1/94  
CHAIRMAN *Harry Huber*

The position of this corner was previously approved by the Kent County Remonumentation Peer Group, monumented by John A. Merdzinski on 10/20/80 and was recorded per LCRC #1431

B. Description of corner evidence found and/or method applied in restoring or reestablishing corner:


I-4 Found standard Kent Co. Mon. (Harrison) per witnesses from above LCRC as set by John A. Merdzinski in place of the Concrete Monument he found. Said Concrete Monument checks with Kent Co. Wit. & LCRC #301.

LCRC #1431	LCRC #4948
SE cor. brick apt. bldg. "O"	N30°W 72.52'
SW cor. brick apt. bldg. "N"	N50°E 82.88'
SW cor. brick apt. bldg. "O"	N75°W 108.48'
Nail & KC tag W. face 6" Hickory	S35°W 39.82'
Nail & KC tag N. face 6" Poplar	S60°E 33.79'
Nail & KC tag N. face W. end fc. post	S68°E 16.54'
South face of curb NE'ly 24.5'	same witnesses as LCRC #1431

The selected location is accepted by me and is generally accepted by professional surveyors as the best available evidence of the position of the original corner.

C. Description of monument for corner and accessories established to perpetuate locating the position of the corner:

I-4 Standard Kent County Monument	
SE cor. brick apt. bldg. "O"	N30°W 72.46'
SW cor. brick apt. bldg. "N"	N50°E 82.88'
SW cor. brick apt. bldg. "O"	N75°W 108.52'
New Nail & KC Remon. tag N. side 18" Poplar	S60°E 33.66'
Nail & KC Remon. tag N. side W. end fc. post	S68°E 16.54'
Set Nail & KC Remon. tag E. side 16" Elm	S00°W 22.27'
South face of curb NE'ly 24.4'	

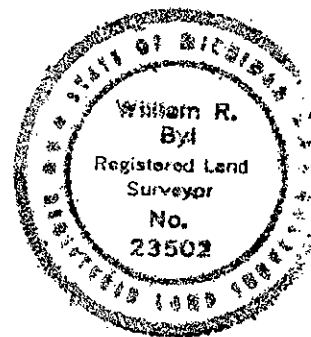

Signed by *W. R. Byl* Date 112794  
Surveyor's Michigan License No. 23502