

SURVEY & REMONUMENTATION

KENT COUNTY REMONUMENTATION

APR 27 1995

LAND CORNER RECORDATION CERTIFICATE
Filing Requirement of Act 74, Mich. P.A. 1970

STATE OF MICHIGAN
COUNTY OF KENT
RECEIVED FOR RECORD
94 DEC -5 AM 8:58

For corners in **COMMISSION**
KENT COUNTY
(County)


	Located In:	Corner Code #
1. Public Land Survey	T <u>6N</u> R <u>11W</u>	<u>I-5</u>
	T _____ R _____	_____
	T _____ R _____	_____
	T _____ R _____	_____
2. Property Controlling in Section	S _____ T _____ R _____	_____
	S _____ T _____ R _____	_____
3. Miscellaneous Property in Sec.	S _____ T _____ R _____	_____
	S _____ T _____ R _____	_____

Luigi J. Bond
REG. OF DEEDS

7675

Register of Deeds Stamp & File Number

- 4. Lot No. _____, Recorded Plat _____
- 5. Private Claims _____

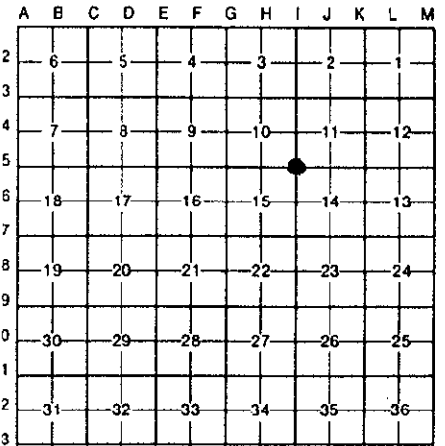

I, William R. Byl, in a field survey on Sept. 20, 1994, do hereby certify that under requirements of P.A. 74, Michigan P.A. of 1970, the corner points mentioned in lines 1 and 2 above were in conformance with regulations and rules therefore as required in the current manual of survey instructions of the United States Department of the Interior, Bureau of Land Management or by a decree of a Court of Law and/or that the corner points mentioned in lines 3, 4 and 5 above were in conformance with the rules of the Michigan Board of Land Surveyors or by a Decree of a Court of Law; established, re-established, monumented, re-monumented, recovered, found as expressed below:

NOTE: Not more than 4 corners, all in the same town and range, may be recorded on this certificate.

A. Description of original monument and accessories and/or subsequent restoration:

P.A. 345 1990 KENT COUNTY

PEER APPROVED 12/1/94
CHAIRMAN *Harry Huber*

I-5	1831	GLO	Mullett	Set Post
	1972	LCRC #273	VanKooten	3/4" Iron in mon. box
	1977	LCRC #1066	McCloskey	Mon. box
	1981	LCRC #2034	Hackbardt	Set Kent County Monument in mon. box
	1989	LCRC #4949	Bueche	Kent County Monument in mon. box

The position of this corner was previously approved by the Kent County Remonumentation Peer Group, monumented by Glen S. Hackbardt on 6/11/81 and was recorded per LCRC #2034

B. Description of corner evidence found and/or method applied in restoring or reestablishing corner:

I-5 Found standard Kent Co. Mon. (Harrison) in mon. box per witnesses from above LCRC as set by Glen S. Hackbardt in place of the 3/4" Iron he found inside a mon. box. Said Iron in mon. box checks with LCRC's #273 & #1066.

LCRC #2034


LCRC #4949

Face 1.7' dia. conc. base to Lt. Pole	S50°E	69.95'	same witnesses as LCRC #2034
C/L of manhole	N05°E	37.96'	
C/L of manhole	S45°W	61.17'	
C/L of manhole	N40°W	81.90'	

The selected location is accepted by me and is generally accepted by professional surveyors as the best available evidence of the position of the original corner.

C. Description of monument for corner and accessories established to perpetuate locating the position of the corner:

I-5 Standard Kent County Monument in mon. box		
Face 1.7' dia. conc. base to Lt. Pole	S50°E	70.10'
C/L of manhole	N05°E	38.01'
C/L of manhole	S45°W	61.68'
C/L of manhole	N40°W	81.90'
SE corner brick sign base	N50°E	93.59'
SE corner brick planter	N05°E	73.06'

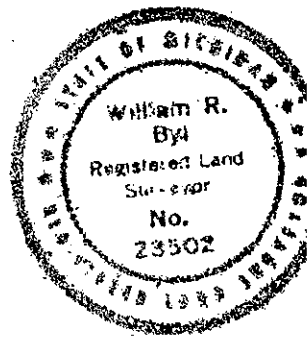

Signed by *W. R. Byl*
Surveyor's Michigan License No. 23502

Date 11/27/94