

SURVEY & REMONUMENTATION

APR 27 1995

KENT COUNTY REMONUMENTATION

COMMISSION LAND CORNER RECORDATION CERTIFICATE

Filing Requirement of Act 74, Mich. P.A. 1970

STATE OF MICHIGAN
COUNTY OF KENT
RECEIVED FOR RECORD

94 DEC -5 AM 8:59

William R. Byl
REG. OF DEEDS

For corners in
KENT COUNTY
(County)

Located In:	Corner Code #
T 6N R 11W	I-11
T R	
T R	
T R	
T R	
S T R	
S T R	
S T R	
S T R	

- Public Land Survey
- Property Controlling in Section
- Miscellaneous Property in Sec.

7680

Register of Deeds Stamp & File Number

- Lot No. _____, Recorded Plat _____
- Private Claims _____

I, William R. Byl, in a field survey on Sept. 6, 1994, do hereby certify that under requirements of P.A. 74, Michigan P.A. of 1970, the corner points mentioned in lines 1 and 2 above were in conformance with regulations and rules therefore as required in the current manual of survey instructions of the United States Department of the Interior, Bureau of Land Management or by a decree of a Court of Law and/or that the corner points mentioned in lines 3, 4 and 5 above were in conformance with the rules of the Michigan Board of Land Surveyors or by a Decree of a Court of Law; established, re-established, monumented, re-monumented, recovered, found as expressed below:

NOTE: Not more than 4 corners, all in the same town and range, may be recorded on this certificate.

	A	B	C	D	E	F	G	H	I	J	K	L	M
2	6	5	4	3	2	1							
3													
4	7	8	9	10	11	12							
5													
6	18	17	16	15	14	13							
7													
8	19	20	21	22	23	24							
9													
10	30	29	28	27	26	25							
11													
12	31	32	33	34	35	36							
13													

A. Description of original monument and accessories and/or subsequent restoration:

I-11	1831	GLO	Mullett	Set Post	P.A. 345 1990 KENT COUNTY
		Kent Co. Wit.		Stone	PEER APPROVED 12/1/94
	1974	LCRC #741	Bonnema	"T" Iron	CHAIRMAN <i>Harry Huber</i>
	1974	LCRC #768	Spicer	"T" Iron	
	1982	LCRC #3099	Byl	Set Kent County Monument	
	1989	LCRC #4955	Bueche	Kent County Monument	

The position of this corner was previously approved by the Kent County Remonumentation Peer Group, monumented by William R. Byl on 10/14/82 and was recorded per LCRC #3099

B. Description of corner evidence found and/or method applied in restoring or reestablishing corner:

I-11 Found standard Kent Co. Mon. (Harrison) per witnesses from above LCRC as set by William R. Byl in place of the "T" Iron he found over a stone 20" deep. Said "T" Iron checks with Kent Co. Wit. and LCRC's #741 & #768.

LCRC #3099

LCRC #4955


C/L 1 1/2" steel post	South 26.96'	Nail & Remon. tag N. side 14" Pine S70°E	103.63'
Nail & tag 10" Pine	S70°E 103.63'	Nail & Remon. tag S. side 16" Elm N85°E	162.34'
Nail & tag fence post	North 26.54'	Nail & Remon. tag E. side 8" Elm N10°W	66.45'
Nail & tag 10" Pine	S25°E 33.47'	Nail & Remon. tag E. side 8" Elm N55°W	83.15'
Nail & tag 12" Elm	N85°E 162.38'		

The selected location is accepted by me and is generally accepted by professional surveyors as the best available evidence of the position of the original corner.

C. Description of monument for corner and accessories established to perpetuate locating the position of the corner:

I-11 Standard Kent County Monument

New Nail & KC Remon. tag N. side 14" Pine S70°E	103.65'
New Nail & KC Remon. tag S. side 16" Elm N85°E	162.43'
New Nail & KC Remon. tag E. side 8" Elm N10°W	66.49'
New Nail & KC Remon. tag E. side 8" Elm N55°W	83.20'

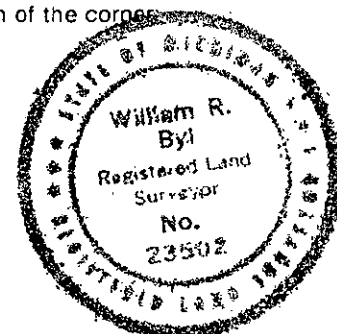

Signed by *William R. Byl* Date 11/27/94

Surveyor's Michigan License No. 23502