

COMMISSION

____ , Recorded Plat .

5. Private Claims

KENT COUNTY REMONUMENTATION

LAND CORNER RECORDATION CERTIFICATE Filing Requirement of Act 74, Mich. P.A. 1970

| | , |
|---------------------------------------|----|
| STATE OF MICHEUA | |
| COUNTY OF KEITT RECEIVED FOR RECOI | B |
| 94 DEC -5 AM A: E | CF |
| . Dru -5 AM A. E | 20 |

n v: 59

| For corners in KENT COUNTY | | 3 · · · · · | 1 | |
|----------------------------|--------------------------|--|----------------|---------------------------------------|
| | (County) | Located In: | Corner Code ## | REG. OF DEEDS |
| 1. | Public Land Survey | T <u>6N</u> R <u>111</u> W T <u>1</u> R | <u>I</u> ±13 | 0,5508 |
| | | T R | | |
| 2. | | S T R | | 7682 |
| 3. | in Section Miscellaneous | S T R S T R | | • |
| J. | Property in Sec. | S T R | | Register of Deeds Stamp & File Number |
| | i i | | | |

William R. Byl, in a field survey on 1, <u>William R. Byl</u>, in a field survey on <u>Aug. 22</u>, 19 <u>94</u>, do hereby certify that under requirements of P.A. 74, Michigan P.A. of 1970, the corner points mentioned in lines 1 and 2 above were in conformance with regulations and rules therefore as required in the current manual of survey instructions of the United States Department of the Interior, Bureau of Land Management or by a decree of a Court of Law and/or that the corner points mentioned in lines 3, 4 and 5 above were in conformance with the rules of the Michigan Board of Land Surveyors or by a Decree of a Court of Law; established, re-established, monumented, re-monumented, recovered, found as expressed below:

NOTE: Not more than 4 corners, all in the same town and range, may be recorded on this certificate.

A. Description of original monument and accessories and/or subsequent restoration:

P.A. 345 1990 KENT COUNTY

S40°W

S80°₩

141.36'

99.48

10

11

12

PEER APPROVED/12/1/94 1831 GLO Mullett. Set Post 1963 Kent Co. Wit. 3/4" Iron 1" Iron in mon. box 1978 LCRC #1136 VanKooten 1981 LCRC #1686 Merdzinski Set Kent County Monument in mon. /box

1989 LCRC #4957 Bueche Kent County Monument in mon. box The position of this corner was previously approved by the Kent County Remonumentation Peer Group, monumented by John A. Merdzinski on 2/24/81 and was recorded per LCRC #1686


B. Description of corner evidence found and/or method applied in restoring or reestablishing corner:

I-13 Found standard Kent Co. Mon. (Harrison) per witnesses from above LCRC as set by John A. Merdzinzki in place of the 1" x 12" over a 3/4" x 12" he found inside a mon Both Iron check with Kent Co. Wit. and LCRC #1136.

LCRC #1686 & 4957 Nail & tag P. Pole Nail & tag 22" Oak S80°E 125.02 NW cor. brick hse. S50°E 75.29' SE cor. hse. brick pillar Nail & tag P. Pole 111.01' N70°W Mon. box. East 10.76' Nail & tag 7" Ash 50.28' N35°W C/L bit. rd. S. is 8' E. Nail & tag 6" Ash N70°E 52.28' C/L E-W bit. rd. is 3'S. SE cor. brick hse. S30°W 149.32

The selected location is accepted by me and is generally accepted by professional surveyors as the best available evidence of the position of the original corner.

C. Description of monument for corner and accessories established to perpetuate locating the position of the corner:

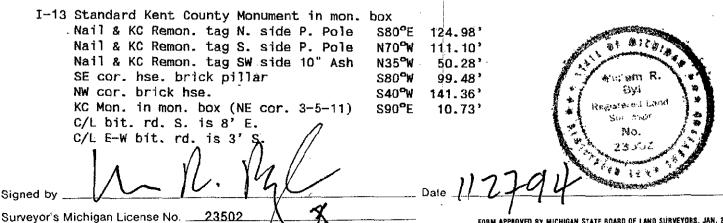

MICHIGAN STATE BOARD OF LAND SURVEYORS, JAN. 28, 1971

REVISED JAN., 1983