

SURVEY & REMONUMENTATION

APR 27 1995

KENT COUNTY REMONUMENTATION

COMMISSION

LAND CORNER RECORDATION CERTIFICATE
Filing Requirement of Act 74, Mich. P.A. 1970

STATE OF MICHIGAN
COUNTY OF KENT
RECEIVED FOR RECORD
94 DEC -5 AM 8:59

For corners in
KENT COUNTY
(County)

Located In:

Corner Code #

- | | | |
|------------------------------------|--------------------------|------------|
| 1. Public Land Survey | T <u>6N</u> R <u>11W</u> | <u>J-1</u> |
| | T _____ R _____ | _____ |
| | T _____ R _____ | _____ |
| | T _____ R _____ | _____ |
| 2. Property Controlling in Section | S _____ T _____ R _____ | _____ |
| | S _____ T _____ R _____ | _____ |
| 3. Miscellaneous Property in Sec. | S _____ T _____ R _____ | _____ |
| | S _____ T _____ R _____ | _____ |

Lee J. Bond
REG. OF DEEDS

7683

Register of Deeds Stamp & File Number

4. Lot No. _____, Recorded Plat _____
5. Private Claims _____

I, William R. Byl, in a field survey on Sept. 29, 1994, do hereby certify that under requirements of P.A. 74, Michigan P.A. of 1970, the corner points mentioned in lines 1 and 2 above were in conformance with regulations and rules therefore as required in the current manual of survey instructions of the United States Department of the Interior, Bureau of Land Management or by a decree of a Court of Law and/or that the corner points mentioned in lines 3, 4 and 5 above were in conformance with the rules of the Michigan Board of Land Surveyors or by a Decree of a Court of Law; established, re-established, monumented, re-monumented, recovered, found as expressed below:

A	B	C	D	E	F	G	H	I	J	K	L	M
2	6	5	4	3	2	1						
3												
4	7	8	9	10	11	12						
5												
6	18	17	16	15	14	13						
7												
8	19	20	21	22	23	24						
9												
10	30	29	28	27	26	25						
11												
12	31	32	33	34	35	36						
13												

NOTE: Not more than 4 corners, all in the same town and range, may be recorded on this certificate.

- A. Description of original monument and accessories and/or subsequent restoration: P.A. 345 1990 KENT COUNTY
PEER APPROVED 12/1/94
CHAIRMAN *Harry H. ...*
- | | | | | |
|-----|------|---------------|------------|----------------------------|
| J-1 | 1831 | GLO | Mullett | Set Post |
| | | Kent Co. Wit. | | Iron |
| | 1972 | LCRC #302 | N.C. Jones | 3/4" ID Pipe with 3 stones |
| | 1973 | LCRC #554 | VanKooten | Iron |
| | 1980 | LCRC #1432 | Merdzinski | Set Kent County Monument |
| | 1991 | LCRC #6375 | Marschall | Kent County Monument |

The position of this corner was previously approved by the Kent County Remonumentation Peer Group, monumented by John A. Merdzinski on 10/20/80 and was recorded per LCRC #1432

- B. Description of corner evidence found and/or method applied in restoring or reestablishing corner:

J-1 Found standard Kent Co. Mon. (Harrison) per witnesses from above LCRC as set by John A. Merdzinski in place of the 3/4" Iron he found with 3 stones. Said Iron checks with Kent Co. Wit. and LCRC #302 & #554.

LCRC #1432


LCRC #6375

Nail & tag Tri. 10" B'wood East	3.71'	Nail & tag Tri. 12" Basswood	S88°E	2.58'
Nail & tag 30" Oak	N75°E 40.51'	Nail & tag 12" Maple	N75°W	6.05'
Nail & tag 14" Ash	N40°E 17.25'	Nail & tag 20" Basswood	S88°W	32.09'
Nail & tag 30" Maple	N10°E 47.00'	Nail & tag 12" Ash	N40°E	17.21'
Nail & tag 10" Maple	N50°W 6.13'	Nail & tag 14" Maple	N01°W	21.24'
C/L 2 1/2" dia. steel cor. fence post to dog run	S05°W 66.25'			

The selected location is accepted by me and is generally accepted by professional surveyors as the best available evidence of the position of the original corner.

- C. Description of monument for corner and accessories established to perpetuate locating the position of the corner:

- J-1 Standard Kent County Monument
- | | | |
|--|-------|--------|
| New Nail & KC Remon. tag N. side Tri. 12" Basswood | S88°E | 2.58' |
| New Nail & KC Remon. tag S. side 12" Maple | N75°W | 6.03' |
| New Nail & KC Remon. tag S. side 20" Basswood | S88°W | 32.12' |
| Nail & KC Remon. tag NW side 12" Ash | N40°E | 17.25' |
| New Nail & KC Remon. tag W. side 14" Maple | N01°W | 21.24' |

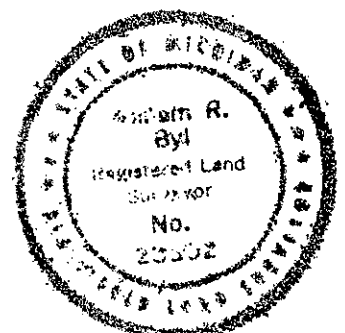

Signed by *W. R. Byl*
Surveyor's Michigan License No. 23502

Date 11/27/94