

\$7.00
\$2.00

JAN 24 1996

KENT COUNTY REMONUMENTATION

COMMISSION LAND CORNER RECORDATION CERTIFICATE
Filing Requirement of Act 74, Mich. P.A. 1970

For corners in
KENT COUNTY
(County)

Located In:

Corner Code #

1. Public Land Survey	T	6N	R	11W	J-2
	T		R		
	T		R		
	T		R		
2. Property Controlling in Section	S		T	R	
	S		T	R	
3. Miscellaneous Property in Section	S		T	R	
	S		T	R	

REG. OF DEEDS

Lucy Bond

STATE OF MICHIGAN
COUNTY OF KENT
RECEIVED FOR RECORD
95 DEC 20 AM 8:38

8796

Register of Deeds Stamp & File Number

4. Lot No. _____, Recorded Plat _____
5. Private Claims _____

A	B	C	D	E	F	G	H	I	J	K	L	M
2	6	5	4	3	2	1						
3												
4	7	8	9	10	11	12						
5												
6	18	17	16	15	14	13						
7												
8	19	20	21	22	23	24						
9												
10	30	29	28	27	26	25						
11												
12	31	32	33	34	35	36						
13												

I, Kirk Breitels, in a field survey on Nov. 17, 1994

do hereby certify that under requirements of P.A. 74, Michigan P.A. of 1970, the corner points mentioned in lines 1 and 2 above were in conformance with regulations and rules therefore as required in the current manual of survey instructions of the United States Department of the Interior, Bureau of Land Management or by a decree of a Court of Law and/or that the corner points mentioned in lines 3, 4 and 5 above were in conformance with the rules of the Michigan Board of Professional Surveyors or by a Decree of a Court of Law; established, re-established, monumented, re-monumented, recovered, found as expressed below:

NOTE: Not more than 4 corners, all in the same town and range, may be recorded on this certificate.

A. Description of original monument and accessories and/or subsequent restoration:

- J-2 1831 GLO Not Set
- 1928-78 Williams & Works 1" Iron
- 1972 LCRC #303 N.C. Jones 3/4" ID Iron Pipe
- S20°W 35.66' 22" Oak S35°E 28.52' 19" Maple
- N75°E 12.64' 36" Tri. Locust N80°W 28.32' 19" Maple
- 1978 LCRC #1170 Merdzinski 1" Iron
- Nail 26" Oak S30°W 35.65' Nail 20" Maple S45°E 28.55'
- Nail Tri. 20" Ash N75°E 12.60' Nail 22" Maple West 28.35'
- C/L 10' wide trail is S. 10' Fence line N. is W. 4.5'

B. Description of corner evidence found and/or method applied in restoring or reestablishing corner:


J-2 Found 1" Iron Pipe that fits the remaining of the above witnesses. Said Iron Pipe is 17.8' N. & 6.3' E. from true intersection of 1/4 lines. Iron Pipe used in many surveys by various surveyors.

The 1" Iron Pipe is accepted by me and is generally accepted by professional surveyors as the best available evidence of the position of the corner.

P.A. 345 1990 KENT COUNTY
PEER APPROVED 11/17/94
CHAIRMAN Harry Huber

C. Description of monument for corner and accessories established to perpetuate locating the position of the corner:

- J-2 Set Standard Kent County Monument in place of the 1" Iron Pipe
- Set Nail & KC Remon. tag W. side 30" Oak S30°W 35.90'
- Set Nail & KC Remon. tag W. side 24" Maple S45°E 28.53'
- Set Nail & KC Remon. tag S. side Tri. 24" Ash N75°E 12.62'
- Set Nail & KC Remon. tag N. side 27" Maple S90°W 28.36'
- Set Nail & KC Remon. tag E. side 8" Maple N00°E 22.68'
- Center line of trail - South 10'±
- Remains of fence to North - West 4'±

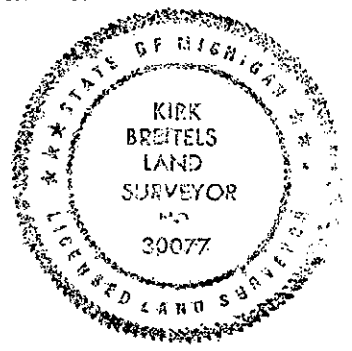

Signed by Kirk Breitels

Date 12/11/95

Surveyor's Michigan License No. 30077