

JAN 24 1996

KENT COUNTY REMONUMENTATION

\$7.00  
\$2.00

COMMISSION

LAND CORNER RECORDATION CERTIFICATE  
Filing Requirement of Act 74, Mich. P.A. 1970

For corners in  
KENT COUNTY  
(County)

Located In:

Corner Code #

1. Public Land Survey	T	6N	R	11W	J-4
	T		R		
	T		R		
	T		R		
2. Property Controlling in Section	S		T	R	
	S		T	R	
3. Miscellaneous Property in Section	S		T	R	
	S		T	R	

- 4. Lot No. \_\_\_\_\_, Recorded Plat \_\_\_\_\_
- 5. Private Claims \_\_\_\_\_

STATE OF MICHIGAN  
COUNTY OF KENT  
RECEIVED FOR RECORD

95 DEC 20 AM 8:39

REG. OF DEEDS  
*Luc Stoddard*

8806

Register of Deeds Stamp & File Number

I, Kirk Breitels, in a field survey on Nov. 15, 1994

do hereby certify that under requirements of P.A. 74, Michigan P.A. of 1970, the corner points mentioned in lines 1 and 2 above were in conformance with regulations and rules therefore as required in the current manual of survey instructions of the United States Department of the Interior, Bureau of Land Management or by a decree of a Court of Law and/or that the corner points mentioned in lines 3, 4 and 5 above were in conformance with the rules of the Michigan Board of Professional Surveyors or by a Decree of a Court of Law; established, re-established, monumented, re-monumented, recovered, found as expressed below:

NOTE: Not more than 4 corners, all in the same town and range, may be recorded on this certificate.

A	B	C	D	E	F	G	H	I	J	K	L	M
2	6	5	4	3	2							
3												
4	7	8	9	10	11	12						
5												
6	18	17	16	15	14	13						
7												
8	19	20	21	22	23	24						
9												
10	30	29	28	27	26	25						
11												
12	31	32	33	34	35	36						
13												

A. Description of original monument and accessories and/or subsequent restoration:

J-4 1831 GLO Not Set  
 1929-63 Williams & Works Iron in fence cor.  
 1961 Kent Co. Wit. Iron in fence cor.  
 1969-75 Williams & Works Solid Iron in mon. box  
 C/L MH SSW 16.45' Back Walk S. 32.0' 8" Elm NE 66.84'  
 1972 LCRC #305 N.C. Jones 1/2" Iron in bit. pavmnt.  
 N05°E 53.67' 15" Elm N20°E 24.76' C/L Hydr.  
 N50°E 66.39' 8" Elm South 47.23' 9" Maple  
 Exxel Eng. Used per Williams & Works 1973 info.

B. Description of corner evidence found and/or method applied in restoring or reestablishing corner:


J-4 Found Capped Rerod in mon. box in bit. pavement. Said Rerod fits the remaining witnesses of those above and survey data by others. Said Rerod is 3.7' E. & 1.4' N. from true intersection of 1/4 lines.

The Capped Rerod in mon. box is accepted by me and is generally accepted by professional surveyors as the best available evidence of the position of the corner.

P.A. 345 1990 KENT COUNTY  
 PEER APPROVED 11/17/94  
 CHAIRMAN Harry Huber

C. Description of monument for corner and accessories established to perpetuate locating the position of the corner:

J-4 Set Standard Kent County Monument in place of the Capped Rerod in a mon. box  
 Set Nail & KC Remon. tag E. side 22" Elm N05°E 54.22'  
 Top center of fire hydrant N20°E 24.75'  
 Set Nail & KC Remon. tag SE side 14" Elm N50°E 67.14'  
 Set Nail & KC Remon. tag W. side 16" Maple S00°E 46.89'  
 Centerline of manhole S40°W 16.45'

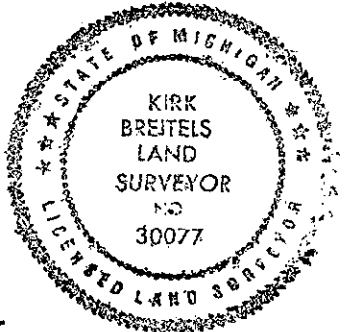

Signed by Kirk Breitels

Date 12/11/95

Surveyor's Michigan License No. 30077