

SURVEY & REMONUMENTATION

APR 27 1995

KENT COUNTY REMONUMENTATION

COMMISSION

LAND CORNER RECORDATION CERTIFICATE
Filing Requirement of Act 74, Mich. P.A. 1970

STATE OF MICHIGAN
COUNTY OF KENT
RECEIVED FOR RECORD

94 DEC -5 AM 8:59

W. R. Byl
REG. OF DEEDS

For corners in
KENT COUNTY
(County)

| | Located In: | Corner Code # |
|------------------------------------|--------------------------|---------------|
| 1. Public Land Survey | T <u>6N</u> R <u>11W</u> | <u>J-5</u> |
| | T _____ R _____ | _____ |
| | T _____ R _____ | _____ |
| | T _____ R _____ | _____ |
| 2. Property Controlling in Section | S _____ T _____ R _____ | _____ |
| | S _____ T _____ R _____ | _____ |
| 3. Miscellaneous Property in Sec. | S _____ T _____ R _____ | _____ |
| | S _____ T _____ R _____ | _____ |

7685

Register of Deeds Stamp & File Number

4. Lot No. _____, Recorded Plat _____
5. Private Claims _____

I, William R. Byl, in a field survey on Sept. 20, 19 94, do hereby certify that under requirements of P.A. 74, Michigan P.A. of 1970, the corner points mentioned in lines 1 and 2 above were in conformance with regulations and rules therefore as required in the current manual of survey instructions of the United States Department of the Interior, Bureau of Land Management or by a decree of a Court of Law and/or that the corner points mentioned in lines 3, 4 and 5 above were in conformance with the rules of the Michigan Board of Land Surveyors or by a Decree of a Court of Law; established, re-established, monumented, re-monumented, recovered, found as expressed below:

| | A | B | C | D | E | F | G | H | I | J | K | L | M |
|----|----|----|----|----|----|----|---|---|---|---|---|---|---|
| 2 | 6 | 5 | 4 | 3 | 2 | 1 | | | | | | | |
| 3 | | | | | | | | | | | | | |
| 4 | 7 | 8 | 9 | 10 | 11 | 12 | | | | | | | |
| 5 | | | | | | | | | | | | | |
| 6 | 18 | 17 | 16 | 15 | 14 | 13 | | | | | | | |
| 7 | | | | | | | | | | | | | |
| 8 | 19 | 20 | 21 | 22 | 23 | 24 | | | | | | | |
| 9 | | | | | | | | | | | | | |
| 10 | 30 | 29 | 28 | 27 | 26 | 25 | | | | | | | |
| 11 | | | | | | | | | | | | | |
| 12 | 31 | 32 | 33 | 34 | 35 | 36 | | | | | | | |

NOTE: Not more than 4 corners, all in the same town and range, may be recorded on this certificate.

A. Description of original monument and accessories and/or subsequent restoration:

P.A. 345 1980 KENT COUNTY

PEER APPROVED 12/1/94
CHAIRMAN *Harry Stuber*

| J-5 | Year | Witness | Monument | Description |
|-----|------|---------------|------------|--------------------------------------|
| | 1831 | GLO | Mullett | Set Post |
| | 1963 | Kent Co. Wit. | | Pointed stone in mon. box |
| | 1973 | LCRC #464 | Spicer | C/L Mon. Box |
| | 1977 | LCRC #1066 | McCloskey | Mon. Box |
| | 1982 | LCRC #3103 | Merdzinski | Set Kent County Monument in mon. box |
| | 1989 | LCRC #4959 | Bueche | Kent County Monument in mon. box |

The position of this corner was previously approved by the Kent County Remonumentation Peer Group, monumented by John A. Merdzinski on 11/1/82 and was recorded per LCRC #3103

B. Description of corner evidence found and/or method applied in restoring or reestablishing corner:


J-5 Found standard Kent Co. Mon. (Harrison) per witnesses from above LCRC as set by John A. Merdzinski in place of the 1/2" Rebar he found over a 1" Iron inside a mon. box. Both Irons in mon. box checks with Kent Co. Wit. and LCRC's #464 & #1066.

| LCRC #3103 | LCRC #4959 |
|----------------------------------|--|
| "X" cut on curb N12°E 62.37' | "X" cut on curb at SE cor. pkg. lot N12°E 62.37' |
| "X" cut on curb S77°E 92.48' | "X" cut on curb 0.5' W. of CB S77°E 92.48' |
| SE cor. brk. bldg. N32°W 115.56' | SE cor. brick building N32°W 115.56' |
| Top C/L hydr. South 43.65' | Top C/L hydrant South 43.65' |
| PK Nail C/L joint North 2.85' | SW cor. header of CB S77°E 93.30' |
| | Nail & Remon. tag in curb joint S70°W 80.39' |

The selected location is accepted by me and is generally accepted by professional surveyors as the best available evidence of the position of the original corner.

C. Description of monument for corner and accessories established to perpetuate locating the position of the corner:

| J-5 Standard Kent County Monument in mon. box | Angle | Distance |
|---|-------|----------|
| Top C/L hydrant | S00°E | 43.65' |
| SW cor. header of CB | S77°E | 93.35' |
| Nail & KC Remon. tag in curb joint | S70°W | 80.45' |
| Back of curbs @ SE cor. parking lot | N10°E | 62.06' |
| SE'ly face of pillar at building | N30°W | 113.38' |
| Back of curbs @ SW cor. parking lot | N45°W | 89.84' |

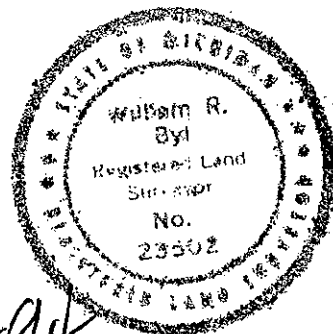

Signed by *W. R. Byl*
Surveyor's Michigan License No. 23502

Date 11/27/94