

SURVEY & REMONUMENTATION

APR 27 1995

KENT COUNTY REMONUMENTATION

COMMISSION LAND CORNER RECORDATION CERTIFICATE
Filing Requirement of Act 74, Mich. P.A. 1970

STATE OF MICHIGAN
COUNTY OF KENT
RECEIVED FOR RECORD

94 DEC -5 AM 8:59

W. R. Byl
REG. OF DEEDS

For corners in
KENT COUNTY
(County)

	Located In:	Corner Code #
1. Public Land Survey	T <u>6N</u> R <u>11W</u>	<u>J-7</u>
	T _____ R _____	_____
	T _____ R _____	_____
	T _____ R _____	_____
2. Property Controlling in Section	S _____ T _____ R _____	_____
	S _____ T _____ R _____	_____
3. Miscellaneous Property in Sec.	S _____ T _____ R _____	_____
	S _____ T _____ R _____	_____
4. Lot No. _____, Recorded Plat _____		
5. Private Claims _____		

7686

Register of Deeds Stamp & File Number

I, William R. Byl, in a field survey on Sept. 9, 1994, do hereby certify that under requirements of P.A. 74, Michigan P.A. of 1970, the corner points mentioned in lines 1 and 2 above were in conformance with regulations and rules therefore as required in the current manual of survey instructions of the United States Department of the Interior, Bureau of Land Management or by a decree of a Court of Law and/or that the corner points mentioned in lines 3, 4 and 5 above were in conformance with the rules of the Michigan Board of Land Surveyors or by a Decree of a Court of Law; established, re-established, monumented, re-monumented, recovered, found as expressed below:

NOTE: Not more than 4 corners, all in the same town and range, may be recorded on this certificate.

	A	B	C	D	E	F	G	H	I	J	K	L	M
2	6	5	4	3	2	1							
3													
4	7	8	9	10	11	12							
5													
6	18	17	16	15	14	13							
7													
8	19	20	21	22	23	24							
9													
10	30	29	28	27	26	25							
11													
12	31	32	33	34	35	36							
13													

A. Description of original monument and accessories and/or subsequent restoration:

Date	Surveyor	Monument	Accessories	Restoration
J-7 1831	GLO	Mullett	Set Post	
1963	Kent Co. Wit.		Iron	
1973	LCRC #589	Spicer	3/4" Iron	
1981	LCRC #2034	Hackbardt	Set Kent County Monument	
1989	LCRC #4960	Bueche	Kent County Monument	
1993	LCRC #6755	Roon	Kent County Monument	

P.A. 345 1990 KENT COUNTY

PEER APPROVED 12/1/94
CHAIRMAN *Harry Huber*

The position of this corner was previously approved by the Kent County Remonumentation Peer Group, monumented by Glen S. Hackbardt on 6/11/81 and was recorded per LCRC #2034

B. Description of corner evidence found and/or method applied in restoring or reestablishing corner:


J-7 Found standard Kent Co. Mon. (Harrison) per witnesses from above LCRC as set by Glen S. Hackbardt in place of the 3/4" x 18" Iron he found over a 1" x 18" crimped iron. Both Irons check with Kent Co. Wit. and LCRC #589.

LCRC #2034 & #4960	LCRC #6755		
Nail & tag 24" Oak	North 76.03'	KC Nail & tag 14" Ash	N65°E 66.24'
Nail & tag 14" Ash	N45°E 61.02'	Prop. Iron w/cap #8618	N00°E 33.00'
Nail & tag 14" Ash	N65°E 66.28'	Nail & tag 16" Pine	S30°E 48.71'
C/L hydrant	S80°E 136.20'	Nail & tag 11" Elm	S25°W 32.24'
C/L manhole	S10°W 22.73'		

The selected location is accepted by me and is generally accepted by professional surveyors as the best available evidence of the position of the original corner.

C. Description of monument for corner and accessories established to perpetuate locating the position of the corner:

Monument	Direction	Distance
J-7 Standard Kent County Monument		
New Nail & KC Remon. tag W. side 24" Oak	N00°E	75.99'
New Nail & KC Remon. tag NW side 14" Ash	N65°E	66.22'
Nail & MDOT tag E. side 20" Pine	S30°E	48.69'
Nail & MDOT tag W. side 11" Elm	S25°W	32.24'
Prop. Iron w/cap #8618	N00°E	33.00'
C/L manhole	S10°W	22.73'
C/L hydrant	S80°E	136.06'
Set Nail & KC Remon. tag NW side 12" Elm	N45°E	54.00'

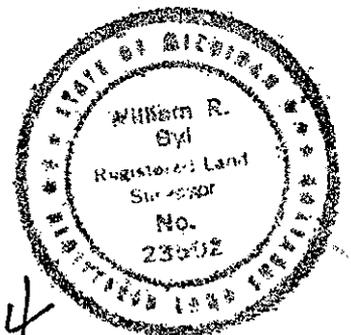

Signed by *W. R. Byl*
Surveyor's Michigan License No. 23502

Date 112794