

JAN 24 1996

KENT COUNTY REMONUMENTATION

COMMISSION LAND CORNER RECORDATION CERTIFICATE
Filing Requirement of Act 74, Mich. P.A. 1970

\$7.00
\$2.00

For corners in
KENT COUNTY
(County)

Located In:

Corner Code #

- 1. Public Land Survey T 6N R 11W J-8
- T R
- T R
- T R
- 2. Property Controlling S T R
- in Section S T R
- 3. Miscellaneous S T R
- Property in Section S T R
- 4. Lot No. _____, Recorded Plat _____
- 5. Private Claims _____

REG. OF DEEDS
Lucy Bond

STATE OF MICHIGAN
COUNTY OF KENT
RECEIVED FOR RECORD
95 DEC 20 AM 8:40

8819

Register of Deeds Stamp & File Number

A	B	C	D	E	F	G	H	I	J	K	L	M
2	6	5	4	3	2	1						
3												
4	7	8	9	10	11	12						
5												
6	18	17	16	15	14	13						
7												
8	19	20	21	22	23	24						
9												
10	30	29	28	27	26	25						
11												
12	31	32	33	34	35	36						
13												

I, Kirk Breitels, in a field survey on Dec. 1, 1994

do hereby certify that under requirements of P.A. 74, Michigan P.A. of 1970, the corner points mentioned in lines 1 and 2 above were in conformance with regulations and rules therefore as required in the current manual of survey instructions of the United States Department of the Interior, Bureau of Land Management or by a decree of a Court of Law and/or that the corner points mentioned in lines 3, 4 and 5 above were in conformance with the rules of the Michigan Board of Professional Surveyors or by a Decree of a Court of Law; established, re-established, monumented, re-monumented, recovered, found as expressed below:

NOTE: Not more than 4 corners, all in the same town and range, may be recorded on this certificate.

A. Description of original monument and accessories and/or subsequent restoration:

- J-8 1831 GLO Not Set 1920-57 Williams & Works Uses ? for corner
- 1958-69 Williams & Works Set and uses at "X" 1/4 lines
- 24" Ash NNE 62.45' 10" Elm SE 4.20' 16" Ash East 8.90'
- 1959 Kent Co. Wit. Iron (same wits. as Williams & Works)
- Consumers Power Co. Set capped iron
- 1987 Williams & Works Set "T" Iron at prev. position
- 8" Elm S. 52.35' 8" Ash E. 11.71' 6" Maple W. 11.15'
- 10" Maple N50°E 26.23' Fence E-W is S. 2.8' Fence N-S is E. 11'
- Exxel Eng. Using comp. "X" 1/4 lines

B. Description of corner evidence found and/or method applied in restoring or reestablishing corner:


J-8 Found "T" Iron from 1987 Williams & Works witnesses. Also found capped Consumers Power Co. Iron 0.6' E. & 0.7' S. of "T" Iron. Said "T" Iron is 0.1' W. & 0.4' N. from true intersection of 1/4 lines. CP Co. Iron is 0.2' S. and 0.5' E. from true intersection of 1/4 lines.

The "T" Iron is accepted by me and is generally accepted by professional surveyors as the best available evidence of the position of the corner.

P.A. 345 1990 KENT COUNTY
PEER APPROVED 12/11/94
CHAIRMAN Henry Huber

C. Description of monument for corner and accessories established to perpetuate locating the position of the corner:

- J-8 Set Standard Kent County Monument in place of the "T" Iron.
- Set Nail & KC Remon. tag N. side 10" Ash S90°E 11.67'
- Set Nail & KC Remon. tag N. side 12" Ash S90°W 11.11'
- Set Nail & KC Remon. tag NW side 10" Maple N50°E 26.19'
- Set Nail & KC Remon. tag W. side 5" Ash S00°W 22.44'
- Fd. Nail & MDSH tag NW side 12" Maple S35°W 7.55'
- Capped Consumer Power Iron S40°E 0.88'
- E-W fence is 3'± South; N-S fence is 11'± East

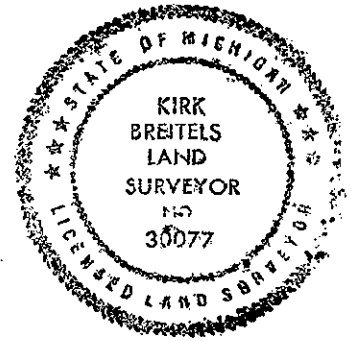

Signed by Kirk Breitels

Date 12/11/95

Surveyor's Michigan License No. 30077