

SURVEY & REMONUMENTATION

APR 27 1995

COMMISSION

KENT COUNTY REMONUMENTATION

STATE OF MICHIGAN
COUNTY OF KENT
RECEIVED FOR RECORD

LAND CORNER RECORDATION CERTIFICATE
Filing Requirement of Act 74, Mich. P.A. 1970

DEC -5 AM 8:59

For corners in
KENT COUNTY
(County)

Located In: Corner Code #


1. Public Land Survey	T	<u>6N</u>	R	<u>11W</u>	<u>K-3</u>
	T	_____	R	_____	_____
	T	_____	R	_____	_____
	T	_____	R	_____	_____
2. Property Controlling in Section	S	_____	T	_____	R
	S	_____	T	_____	R
3. Miscellaneous Property in Sec.	S	_____	T	_____	R
	S	_____	T	_____	R

W. R. Byl
REG. OF DEEDS

7692

Register of Deeds Stamp & File Number

- 4. Lot No. _____, Recorded Plat _____
- 5. Private Claims _____

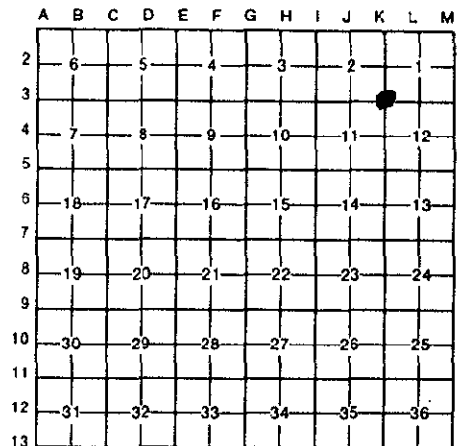

I, William R. Byl, in a field survey on Aug. 18, 19 94, do hereby certify that under requirements of P.A. 74, Michigan P.A. of 1970, the corner points mentioned in lines 1 and 2 above were in conformance with regulations and rules therefore as required in the current manual of survey instructions of the United States Department of the Interior, Bureau of Land Management or by a decree of a Court of Law and/or that the corner points mentioned in lines 3, 4 and 5 above were in conformance with the rules of the Michigan Board of Land Surveyors or by a Decree of a Court of Law; established, re-established, monumented, re-monumented, recovered, found as expressed below:

NOTE: Not more than 4 corners, all in the same town and range, may be recorded on this certificate.

A. Description of original monument and accessories and/or subsequent restoration:

K-3	1831	GLO	Mullett	Set Post
		Kent Co. Wit.		Iron
	1973	LCRC #605	VanKooten	RR Spike
	1981	LCRC #2029	Hackbardt	Set Kent County Monument
	1984	LCRC #4045	Byl	Reset KC Mon. in mon. box after const.
	1989	LCRC #4965	Bueche	Kent County Monument

P.A. 345 1990 KENT COUNTY
PEER APPROVED 12/1/94
CHAIRMAN *Fanny Huber*

The position of this corner was previously approved by the Kent County Remonumentation Peer Group, monumented by Glen S. Hackbardt on 6/10/81 and was recorded per LCRC #2029

B. Description of corner evidence found and/or method applied in restoring or reestablishing corner:

K-3 Found standard Kent Co. Mon. (Harrison) in mon. box per witnesses from above LCRC as set by William R. Byl at the same location as set in 1981 by Glen S. Hackbardt in place of the 3/4" x 15" pointed bolt inside a 1 3/4" x 30" crimped iron he found. Said crimped iron w/bolt checks with LCRC #605.

LCRC #2029		LCRC #4965	
Nail & tag 30" Hickory	S75°W 88.78'	Nail & Remon. tag P. Pole	N50°E 57.36'
C/L manhole	S20°W 35.12'	Nail & Remon. tag P. Pole	S40°E 68.74'
C/L manhole	N50°W 25.63'	Nail & Remon. tag Guy Pole	S60°W 66.87'
C/L hydrant	N50°E 56.17'	C/L manhole	S90°W 31.20'
C/L S'ly MBT manhole	S30°E 78.73'	C/L manhole	S00°W 5.48'
		Intersection back of walk	N50°W 63.67'
		On C/L bit. rd. N-S-E-W	

The selected location is accepted by me and is generally accepted by professional surveyors as the best available evidence of the position of the original corner.

C. Description of monument for corner and accessories established to perpetuate locating the position of the corner.

K-3 Standard Kent County Monument in mon. box	
Nail & KC Remon. tag N. side P. Pole	N50°E 57.36'
Nail & KC Remon. tag E. side P. Pole	S40°E 68.74'
Set Nail & KC Remon. tag N. side Guy Pole	S60°W 66.82'
C/L manhole	S90°W 31.20'
C/L manhole	S00°W 5.48'
Intersection back of walk	N50°W 62.70'
On C/L bit. rd. N-S-E-W	



Signed by W. R. Byl

Date 23502 112794

Surveyor's Michigan License No. 23502