

SURVEY & REMONUMENTATION

APR 27 1995

COMMISSION

KENT COUNTY REMONUMENTATION

LAND CORNER RECORDATION CERTIFICATE
Filing Requirement of Act 74, Mich. P.A. 1970

STATE OF MICHIGAN
COUNTY OF KENT
RECEIVED FOR RECORD

DEC -5 AM 9:00

For corners in
KENT COUNTY

(County)

Located In:

Corner Code #

- | | | | | | |
|------------------------------------|---|-----------|---|------------|------------|
| 1. Public Land Survey | T | <u>6N</u> | R | <u>11W</u> | <u>K-5</u> |
| | T | _____ | R | _____ | _____ |
| | T | _____ | R | _____ | _____ |
| | T | _____ | R | _____ | _____ |
| 2. Property Controlling in Section | S | _____ | T | _____ | R |
| | S | _____ | T | _____ | R |
| 3. Miscellaneous Property in Sec. | S | _____ | T | _____ | R |
| | S | _____ | T | _____ | R |

W. R. Byl
REG. OF DEEDS

7694

Register of Deeds Stamp & File Number

4. Lot No. _____, Recorded Plat _____
5. Private Claims _____

A	B	C	D	E	F	G	H	I	J	K	L	M
2	6	5	4	3	2	1						
3												
4	7	8	9	10	11	12						
5												
6	18	17	16	15	14	13						
7												
8	19	20	21	22	23	24						
9												
10	30	29	28	27	26	25						
11												
12	31	32	33	34	35	36						
13												

I, William R. Byl, in a field survey on Sept. 20, 1994, do hereby certify that under requirements of P.A. 74, Michigan P.A. of 1970, the corner points mentioned in lines 1 and 2 above were in conformance with regulations and rules therefore as required in the current manual of survey instructions of the United States Department of the Interior, Bureau of Land Management or by a decree of a Court of Law and/or that the corner points mentioned in lines 3, 4 and 5 above were in conformance with the rules of the Michigan Board of Land Surveyors or by a Decree of a Court of Law; established, re-established, monumented, re-monumented, recovered, found as expressed below:

NOTE: Not more than 4 corners, all in the same town and range, may be recorded on this certificate.

A. Description of original monument and accessories and/or subsequent restoration:

K-5	1831	GLO	Mullett	Set Post
	1963	Kent Co. Wit.		RR Spike in mon. box
	1973	LCRC #464	Spicer	RR Spike in mon. box
	1981	LCRC #2036	Hackbardt	Set Kent County Monument in mon. box
	1989	LCRC #4966	Bueche	Kent County Monument in mon. box

P.A. 345 1990 KENT COUNTY
PEER APPROVED 12/1/94
Harry Thayer

The position of this corner was previously approved by the Kent County Remonumentation Peer Group, monumented by Glen S. Hackbardt on 7/24/81 and was recorded per LCRC #2036

B. Description of corner evidence found and/or method applied in restoring or reestablishing corner:

K-5 Found standard Kent Co. Mon. (Harrison) in mon. box per witnesses from above LCRC as set by Glen S. Hackbardt in place of the 1/2" x 18" iron over a solid 3/4" iron he found inside a mon. box. Both irons check with Kent Co. Wit. and LCRC #464.

LCRC #2036


LCRC #4966

SE cor. CB header	N20°E	81.00'	SE cor. CB header	N20°E	81.00'
NW cor. CB header	N55°E	83.80'	NW cor. CB header	N55°E	83.80'
SW cor. CB header	S70°E	75.38'	SW cor. CB header	S70°E	75.38'
C/L pavement	North	10.81'	Nail & Remon. tag NW side P. Pole	S40°W	64.37'

The selected location is accepted by me and is generally accepted by professional surveyors as the best available evidence of the position of the original corner.

C. Description of monument for corner and accessories established to perpetuate locating the position of the corner:

K-5 Standard Kent County Monument in mon. box	
SE cor. CB header	N20°E 81.00'
NW cor. CB header	N55°E 83.94'
SW cor. CB header	S70°E 75.33'
Nail & KC Remon. tag NW side P. Pole	S40°W 64.41'
C/L top of hydrant	N55°W 99.78'
C/L pavement	North 10.81'

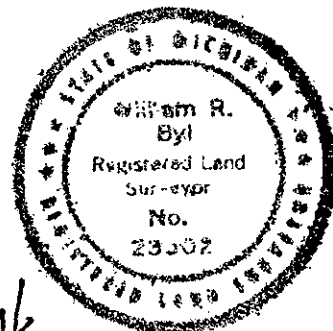

Signed by *W. R. Byl* Date 11/27/94

Surveyor's Michigan License No. 23502