

SURVEY & REMONUMENTATION

APR 27 1995

COMMISSION

KENT COUNTY REMONUMENTATION

STATE OF MICHIGAN
COUNTY OF KENT
RECEIVED FOR RECORD

LAND CORNER RECORDATION CERTIFICATE

Filing Requirement of Act 74, Mich. P.A. 1970

DEC -5 AM 9:00

For corners in
KENT COUNTY

(County)

Located In:

Corner Code #

1. Public Land Survey	T	<u>6N</u>	R	<u>11W</u>	<u>K-8</u>
	T		R		
	T		R		
	T		R		
2. Property Controlling in Section	S		T	R	
	S		T	R	
3. Miscellaneous Property in Sec.	S		T	R	
	S		T	R	

W. R. Byl
REG. OF DEEDS

7697

Register of Deeds Stamp & File Number

4. Lot No. _____, Recorded Plat _____
5. Private Claims _____

A	B	C	D	E	F	G	H	I	J	K	L	M
2	6	5	4	3	2							
3												
4	7	8	9	10	11	12						
5												
6	13	17	16	15	14	13						
7												
8	19	20	21	22	23	24						
9												
10	30	29	28	27	26	25						
11												
12	31	32	33	34	35	36						
13												

I, William R. Byl, in a field survey on July 7, 19 94, do hereby certify that under requirements of P.A. 74, Michigan P.A. of 1970, the corner points mentioned in lines 1 and 2 above were in conformance with regulations and rules therefore as required in the current manual of survey instructions of the United States Department of the Interior, Bureau of Land Management or by a decree of a Court of Law and/or that the corner points mentioned in lines 3, 4 and 5 above were in conformance with the rules of the Michigan Board of Land Surveyors or by a Decree of a Court of Law; established, re-established, monumented, re-monumented, recovered, found as expressed below:

NOTE: Not more than 4 corners, all in the same town and range, may be recorded on this certificate.

A. Description of original monument and accessories and/or subsequent restoration:

K-8	1831	GLD	Mullett	Set Post
	1961	Kent Co. Wit.		3/4" Iron
	1973	LCRC #527	Bonnema	1/4" Iron
	1973	LCRC #589	Spicer	1/2" Iron
	1981	LCRC #2031	Hackbardt	Set Kent County Monument
	1989	LCRC #4969	Bueche	Kent County Monument
	1993	LCRC #6749	Roon	Kent County Monument

P.A. 345 1990 KENT COUNTY
PEER APPROVED 12/1/94
CHAIRMAN *Harry Huber*

The position of this corner was previously approved by the Kent County Remonumentation Peer Group, monumented by Glen S. Hackbardt on 6/11/81 and was recorded per LCRC #2031

B. Description of corner evidence found and/or method applied in restoring or reestablishing corner:

K-8 Found standard Kent Co. Mon. (Harrison) per witnesses from above LCRC as set by Glen S. Hackbardt in place of the 1/4" iron he found over a 1" crimped iron. Both Irons check with Kent Co. Wit. and LCRC's #527 & #589.

LCRC #2031

C/L hydrant	West	28.30'
SE cor. hse. fnd.	N60°W	85.10'
SE cor. hse. fnd.	N40°W	111.28'
KC Nail CP Pole	S85°E	49.90'

LCRC #6749


Nail S. side CP Pole	S85°E	49.90'
Nail & tag S. side P. Pole	S45°W	52.74'
Nail & tag P. Pole	N85°W	36.28'
Nail & tag 22" Willow	N30°W	67.79'

The selected location is accepted by me and is generally accepted by professional surveyors as the best available evidence of the position of the original corner.

C. Description of monument for corner and accessories established to perpetuate locating the position of the corner:

K-8 Standard Kent County Monument

Nail & KC Remon. tag S. side CP Pole	S85°E	49.94'
Nail & KC Remon. tag S. side P. Pole	S45°W	52.72'
New Nail & KC Remon. tag S. side P. Pole	N85°W	36.28'
New Nail & KC Remon. tag SW side 22" Willow	N30°W	67.75'

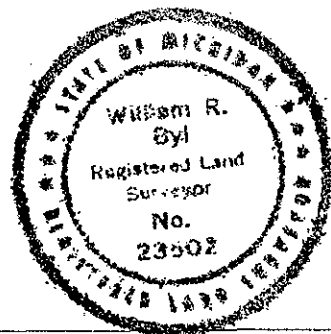

Signed by *W. R. Byl*
Surveyor's Michigan License No. 23502

Date 11/27/94