

SURVEY & REMONUMENTATION

APR 27 1995

COMMISSION

KENT COUNTY REMONUMENTATION

STATE OF MICHIGAN
COUNTY OF KENT
RECEIVED FOR RECORD

LAND CORNER RECORDATION CERTIFICATE 94 DEC -5 AM 9:00
Filing Requirement of Act 74, Mich. P.A. 1970

For corners in
KENT COUNTY

(County)

Located In:

Corner Code #

1. Public Land Survey	T <u>6N</u> R <u>11W</u>	<u>K-10</u>
	T _____ R _____	_____
	T _____ R _____	_____
	T _____ R _____	_____
2. Property Controlling in Section	S _____ T _____ R _____	_____
	S _____ T _____ R _____	_____
3. Miscellaneous Property in Sec.	S _____ T _____ R _____	_____
	S _____ T _____ R _____	_____

W. R. Byl
REG. OF DEEDS

7699

Register of Deeds Stamp & File Number

4. Lot No. _____, Recorded Plat _____
5. Private Claims _____

A	B	C	D	E	F	G	H	I	J	K	L	M
2	6	5	4	3	2							
3												
4	7	8	9	10	11	12						
5												
6	18	17	16	15	14	13						
7												
8	19	20	21	22	23	24						
9												
10	30	29	28	27	26	25						
11												
12	31	32	33	34	35	36						
13												

I, William R. Byl, in a field survey on July 7, 19 94, do hereby certify that under requirements of P.A. 74, Michigan P.A. of 1970, the corner points mentioned in lines 1 and 2 above were in conformance with regulations and rules therefore as required in the current manual of survey instructions of the United States Department of the Interior, Bureau of Land Management or by a decree of a Court of Law and/or that the corner points mentioned in lines 3, 4 and 5 above were in conformance with the rules of the Michigan Board of Land Surveyors or by a Decree of a Court of Law; established, re-established, monumented, re-monumented, recovered, found as expressed below:

NOTE: Not more than 4 corners, all in the same town and range, may be recorded on this certificate.

A. Description of original monument and accessories and/or subsequent restoration:

P.A. 345 1990 KENT COUNTY
PEER APPROVED 12/1/94

CHAIRMAN *Harry Huber*
Set Post
Iron in mon. box
Set Kent County Monument in mon. box
Kent County Monument in mon. box
Kent County Monument

K-10	1831	GLO	Mullett	Set Post
	1952	Kent Co. Wit.		Iron in mon. box
	1984	LCRC #3764	Byl	Set Kent County Monument in mon. box
	1989	LCRC #4971	Bueche	Kent County Monument in mon. box
	1993	LCRC #6752	Roon	Kent County Monument

The position of this corner was previously approved by the Kent County Remonumentation Peer Group, monumented by William R. Byl on 2/10/84 and was recorded per LCRC #3764

B. Description of corner evidence found and/or method applied in restoring or reestablishing corner:

K-10 Found standard Kent Co. Mon. (Harrison) per witnesses from above LCRC as set by William R. Byl in place of the 3/4" Iron Pipe he found over a 1" Iron Pipe inside a mon box. Both Irons in mon. box check with Kent Co. Wit. and survey data by others.

LCRC #3764


LCRC #6752

Nail & tag P. Pole	S65°E	64.98'	Prop Iron w/cap	West	32.99'
Nail & tag 16" Hickory	N90°E	175.95'	Nail & tag W. side 24" Maple	N30°E	65.48'
Nail & tag 20" Maple	N30°E	65.48'	Nail & tag 12" Twin Elm	East	26.60'
Capped Iron (MVK)	N90°W	32.95'	Top fire hydrant	N50°W	237.40'
NW cor. conc. blk pc.	S45°E	200.70'			

The selected location is accepted by me and is generally accepted by professional surveyors as the best available evidence of the position of the original corner.

C. Description of monument for corner and accessories established to perpetuate locating the position of the corner:

K-10 Standard Kent County Monument in mon. box		
Property Iron	N90°W	50.00'
Nail & KC Remon. tag NW side 24" Maple	N30°E	65.48'
New Nail & KC Remon. tag S. side 12" Twin Elm	N90°E	26.64'
Top fire hydrant	N50°W	237.40'
Set Nail & KC Remon. tag NE side P. Pole	N35°W	73.12'

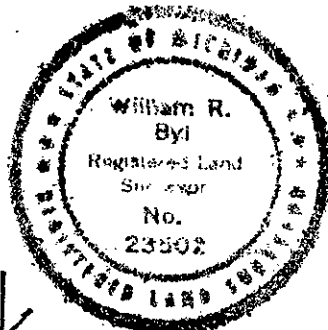

Signed by *W. R. Byl*
Surveyor's Michigan License No. 23502

Date 112794