

SURVEY & REMONUMENTATION

APR 27 1995

COMMISSION

KENT COUNTY REMONUMENTATION

LAND CORNER RECORDATION CERTIFICATE
Filing Requirement of Act 74, Mich. P.A. 1970

STATE OF MICHIGAN
COUNTY OF KENT
RECEIVED FOR RECORD
94 DEC -5 AM 9:00

W. R. Byl
REG. OF DEEDS

For corners in
KENT COUNTY

(County)

Located In:

Corner Code #

- | | | |
|---------------------------------------|--------------------------|-------------|
| 1. Public Land Survey | T <u>6N</u> R <u>11W</u> | <u>K-11</u> |
| | T ___ R ___ | _____ |
| | T ___ R ___ | _____ |
| | T ___ R ___ | _____ |
| 2. Property Controlling in Section | S ___ T ___ R ___ | _____ |
| | S ___ T ___ R ___ | _____ |
| 3. Miscellaneous Property in Sec. | S ___ T ___ R ___ | _____ |
| | S ___ T ___ R ___ | _____ |
| 4. Lot No. _____, Recorded Plat _____ | | |
| 5. Private Claims _____ | | |

7700

Register of Deeds Stamp & File Number

I, William R. Byl, in a field survey on July 7 19 94, do hereby certify that under requirements of P.A. 74, Michigan P.A. of 1970, the corner points mentioned in lines 1 and 2 above were in conformance with regulations and rules therefore as required in the current manual of survey instructions of the United States Department of the Interior, Bureau of Land Management or by a decree of a Court of Law and/or that the corner points mentioned in lines 3, 4 and 5 above were in conformance with the rules of the Michigan Board of Land Surveyors or by a Decree of a Court of Law; established, re-established, monumented, re-monumented, recovered, found as expressed below:

NOTE: Not more than 4 corners, all in the same town and range, may be recorded on this certificate.

A	B	C	D	E	F	G	H	I	J	K	L	M
2	6	5	4	3	2	1						
3												
4	7	8	9	10	11	12						
5												
6	18	17	16	15	14	13						
7												
8	19	20	21	22	23	24						
9												
10	30	29	28	27	26	25						
11												
12	31	32	33	34	35	36						
13												

A. Description of original monument and accessories and/or subsequent restoration:

K-11	1831	GLO	Mullett	Set Post
	1952	Kent Co. Wit.		Iron in mon. box
	1974	LCRC #755	Spicer	3/4" Iron in mon. box
	1976	LCRC #951	Bonnema	1/2" Iron in mon. box
	1982	LCRC #3130	Bonnema	Set Kent County Monument
	1989	LCRC #4972	Bueche	Kent County Monument
	1993	LCRC #6759	Roon	Kent County Monument

P.A. 345 1990 KENT COUNTY

PEER APPROVED 12/11/94
CHAIRMAN *W. R. Byl*

The position of this corner was previously approved by the Kent County Remonumentation Peer Group, monumented by Douglas W. Bonnema on 8/9/82 and was recorded per LCRC #3130

B. Description of corner evidence found and/or method applied in restoring or reestablishing corner:


K-11 Found standard Kent Co. Mon. (Harrison) per witnesses from above LCRC as set by Douglas W. Bonnema in place of the 1/2" Iron he found. Said Iron checks with Kent County Witnesses and LCRC's #755 & #951.

<u>LCRC #3130</u>		<u>LCRC #6759</u>	
NE cor. conc. CP pad	S72°W 84.55'	Nail & tag P. Pole	N40°E 111.81'
Nail & tag W. end CMP	N18°W 79.54'	Nail & tag P. Pole	N75°E 107.90'
Nail & tag E. end CMP	N18°E 79.35'	Nail & tag P. Pole	S60°E 103.22'
PK & tag end curb-gutter	N72°E 65.47'	Top C/L fire hydrant	N50°W 80.30'
PK & tag top conc. culv.	S60°E 51.14'		
C/L sanitary manhole	S51°E 10.23'		

The selected location is accepted by me and is generally accepted by professional surveyors as the best available evidence of the position of the original corner.

C. Description of monument for corner and accessories established to perpetuate locating the position of the corner:

K-11 Standard Kent County Monument			
Nail & KC Remon. tag NE side P. Pole	N40°E	111.73'	
Nail & KC Remon. tag S. side P. Pole	N75°E	107.90'	
Nail & KC Remon. tag N. side P. Pole	S60°E	103.15'	
Top C/L fire hydrant	N50°W	80.18'	
E. cor. conc. base traffic signal pole	S25°W	82.14'	

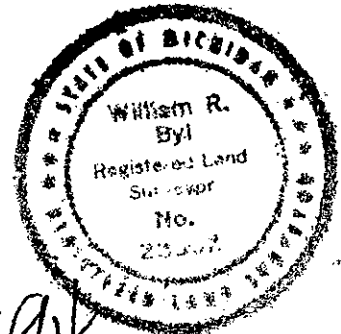

Signed by *W. R. Byl*
Surveyor's Michigan License No. 23502

Date 11/27/94