

JAN 24 1996 KENT COUNTY REMONUMENTATION

\$7.00
\$2.00

COMMISSION LAND CORNER RECORDATION CERTIFICATE
Filing Requirement of Act 74, Mich. P.A. 1970

| For corners in KENT COUNTY (County) | Located In: | Corner Code # |
|---|-------------------------|---------------|
| 1. Public Land Survey | T 6N R 11W | L-2 |
| | T _____ R _____ | _____ |
| | T _____ R _____ | _____ |
| | T _____ R _____ | _____ |
| 2. Property Controlling in Section | S _____ T _____ R _____ | _____ |
| | S _____ T _____ R _____ | _____ |
| 3. Miscellaneous Property in Section | S _____ T _____ R _____ | _____ |
| | S _____ T _____ R _____ | _____ |

STATE OF MICHIGAN
COUNTY OF KENT
RECEIVED FOR RECORD

95 DEC 20 AM 8:38

REG. OF DEEDS

Lucy Grand

8795

Register of Deeds Stamp & File Number

4. Lot No. _____, Recorded Plat _____

5. Private Claims _____

Kirk Breitels Nov. 17 94

I, _____, in a field survey on _____, 19 _____, do hereby certify that under requirements of P.A. 74, Michigan P.A. of 1970, the corner points mentioned in lines 1 and 2 above were in conformance with regulations and rules therefore as required in the current manual of survey instructions of the United States Department of the Interior, Bureau of Land Management or by a decree of a Court of Law and/or that the corner points mentioned in lines 3, 4 and 5 above were in conformance with the rules of the Michigan Board of Professional Surveyors or by a Decree of a Court of Law; established, re-established, monumented, re-monumented, recovered, found as expressed below:

NOTE: Not more than 4 corners, all in the same town and range, may be recorded on this certificate.

| | A | B | C | D | E | F | G | H | I | J | K | L | M |
|----|----|---|----|---|----|---|----|---|----|---|---|---|----|
| 2 | 6 | | 5 | | 4 | | 3 | | 2 | | | | 1 |
| 3 | | | | | | | | | | | | | |
| 4 | 7 | | 8 | | 9 | | 10 | | 11 | | | | 12 |
| 5 | | | | | | | | | | | | | |
| 6 | 18 | | 17 | | 16 | | 15 | | 14 | | | | 13 |
| 7 | | | | | | | | | | | | | |
| 8 | 19 | | 20 | | 21 | | 22 | | 23 | | | | 24 |
| 9 | | | | | | | | | | | | | |
| 10 | 30 | | 29 | | 28 | | 27 | | 26 | | | | 25 |
| 11 | | | | | | | | | | | | | |
| 12 | 31 | | 32 | | 33 | | 34 | | 35 | | | | 36 |

A. Description of original monument and accessories and/or subsequent restoration:

- L-2 1831 GLO Not Set
- 1931-73 Williams & Works Monument
- 14" Tw. Maple N10°E 26.75' 24" Oak N80°E 24.53'
- 28" Maple S05°E 22.16'
- 1972 LCRC #360 Bonnema Concrete Monument
- 40" Maple NNE 26' NW cor. gar. fndn. SSE 90.63'
- 36" Oak ENE 24.5' NE cor. hse. fndn. SE 103.90'

B. Description of corner evidence found and/or method applied in restoring or reestablishing corner:


L-2 Found Concrete Monument at "Center of Section 1" per "Forest Hill Subdivision" (Liber 60, Pg. 45, 1962) that fits remaining witnesses of those above and is 0.6' W. & 0.4' N. from true intersection of 1/4 lines and has been used in many surveys by various surveyors.

The Concrete Monument is accepted by me and is generally accepted by professional surveyors as the best available evidence of the position of the corner.

P.A. 345 1990 KENT COUNTY
PEER APPROVED 11/17/94
CHAIRMAN *Henry Spahr*

C. Description of monument for corner and accessories established to perpetuate locating the position of the corner:

- L-2 Set Standard Kent County Monument in place of the Concrete Monument
- Set Nail & KC Remon. tag E. side 40" Maple N20°E 25.99'
- Set Nail & KC Remon. tag S. side 36" Oak N85°E 24.52'
- Set Nail & KC Remon. tag S. side 14" Maple N80°W 53.64'
- NE cor. hse. fndn. S45°E 103.90'
- NW cor. gar. fndn. S10°E 90.63'

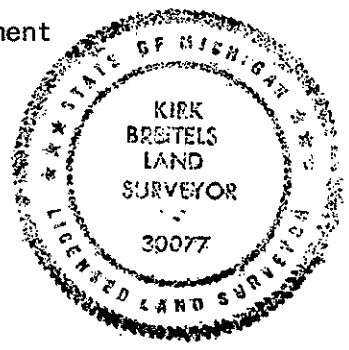

Signed by *Kirk Breitels*
Surveyor's Michigan License No. 30077

Date 12/11/95