

SURVEY & REMONUMENTATION

APR 27 1995

COMMISSION

KENT COUNTY REMONUMENTATION

LAND CORNER RECORDATION CERTIFICATE
Filing Requirement of Act 74, Mich. P.A. 1970

STATE OF MICHIGAN
COUNTY OF KENT
RECEIVED FOR RECORD
94 DEC -5 AM 9:00

W. R. Byl
REG. OF DEEDS

For corners in
KENT COUNTY

(County)	Located In:	Corner Code #
1. Public Land Survey	T <u>6N</u> R <u>11W</u>	<u>L-7</u>
	T _____ R _____	_____
	T _____ R _____	_____
	T _____ R _____	_____
2. Property Controlling in Section	S _____ T _____ R _____	_____
	S _____ T _____ R _____	_____
3. Miscellaneous Property in Sec.	S _____ T _____ R _____	_____
	S _____ T _____ R _____	_____


7706

Register of Deeds Stamp & File Number

4. Lot No. _____, Recorded Plat _____
5. Private Claims _____

I, William R. Byl, in a field survey on Sept. 22, 1994, do hereby certify that under requirements of P.A. 74, Michigan P.A. of 1970, the corner points mentioned in lines 1 and 2 above were in conformance with regulations and rules therefore as required in the current manual of survey instructions of the United States Department of the Interior, Bureau of Land Management or by a decree of a Court of Law and/or that the corner points mentioned in lines 3, 4 and 5 above were in conformance with the rules of the Michigan Board of Land Surveyors or by a Decree of a Court of Law; established, re-established, monumented, re-monumented, recovered, found as expressed below:

NOTE: Not more than 4 corners, all in the same town and range, may be recorded on this certificate.

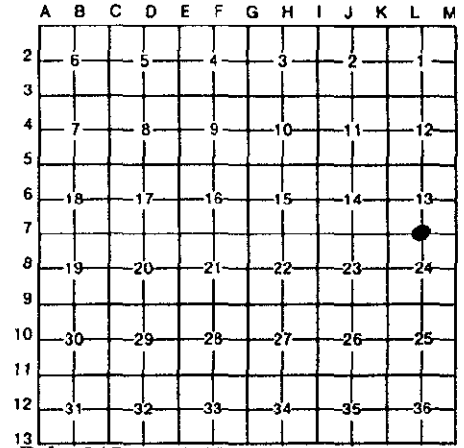

A. Description of original monument and accessories and/or subsequent restoration:

L-7	1831	GLO	Mullett	Set Post
	1964	Kent Co. Wit.		3/4" Iron in mon. box
	1973	LCRC #402	Spicer	3/4" Iron in mon. box
	1981	LCRC #2033	Hackbardt	Set Kent County Monument in mon. box
	1989	LCRC #4977	Bueche	Kent County Monument in mon. box

The position of this corner was previously approved by the Kent County Remonumentation Peer Group, monumented by Glen S. Hackbardt on 7/14/81 and was recorded per LCRC #2033

P.A. 345 1990 KENT COUNTY
PEER APPROVED 12/1/94
CHAIRMAN *Glen S. Hackbardt*

B. Description of corner evidence found and/or method applied in restoring or reestablishing corner:

L-7 Found standard Kent Co. Mon. (Harrison) per witnesses from above LCRC as set by Glen S. Hackbardt in place of the 3/4" x 12" Iron he found inside a mon. box. Said Iron in mon. box checks with Kent Co. Wit. & LCRC #402.

LCRC #2033		LCRC #4977	
NE cor. brk. hse.	S40°E 112.15'	NW bolt at base Lt. Pole	S30°W 101.40'
NW cor. brk. hse.	S20°E 97.80'	C/L hydrant	N65°W 84.00'
NW bolt base Lt. Pole	S30°W 101.40'	N. edge gutter pan	South 24.00'
C/L hydrant	N65°W 84.00'	Cut @ back of curb	S55°E 92.75'
N. edge gutter pan	South 24.00'	On C/L blacktop E-W	

The selected location is accepted by me and is generally accepted by professional surveyors as the best available evidence of the position of the original corner.

C. Description of monument for corner and accessories established to perpetuate locating the position of the corner:

L-7 Standard Kent County Monument

NW bolt at base Lt. Pole	S30°W 101.40'
C/L hydrant	N65°W 84.14'
N. edge gutter pan	S00°E 23.95'
Cut @ back of curb	S55°E 92.69'
Set Nail & KC Remon. tag E. side Lt. Pole	N00°E 25.91'
On C/L blacktop E-W	

Signed by *W. R. Byl*
Surveyor's Michigan License No. 23502

Date 112794

