

JAN 24 1996

KENT COUNTY REMONUMENTATION

\$7.00  
\$2.00

COMMISSION LAND CORNER RECORDATION CERTIFICATE  
Filing Requirement of Act 74, Mich. P.A. 1970

For corners in  
KENT COUNTY  
(County)

Located In:

Corner Code #

1. Public Land Survey	T	6N	R	11W	L-8
	T		R		
	T		R		
	T		R		
2. Property Controlling in Section	S		T	R	
	S		T	R	
3. Miscellaneous Property in Section	S		T	R	
	S		T	R	

REG. OF DEEDS

*Lucy Bond*

95 DEC 20 AM 8:40

STATE OF MICHIGAN  
COUNTY OF KENT  
RECEIVED FOR RECORD

8820

Register of Deeds Stamp & File Number

- 4. Lot No. \_\_\_\_\_, Recorded Plat \_\_\_\_\_
- 5. Private Claims \_\_\_\_\_

A	B	C	D	E	F	G	H	I	J	K	L	M
2	6		5		4		3		2			
3												
4	7		8		9		10		11		12	
5												
6	18		17		16		15		14		13	
7												
8	19		20		21		22		23		24	
9												
10	30		29		28		27		26		25	
11												
12	31		32		33		34		35		36	
13												

I, Kirk Breitels, in a field survey on Nov. 15, 19 94, do hereby certify that under requirements of P.A. 74, Michigan P.A. of 1970, the corner points mentioned in lines 1 and 2 above were in conformance with regulations and rules therefore as required in the current manual of survey instructions of the United States Department of the Interior, Bureau of Land Management or by a decree of a Court of Law and/or that the corner points mentioned in lines 3, 4 and 5 above were in conformance with the rules of the Michigan Board of Professional Surveyors or by a Decree of a Court of Law; established, re-established, monumented, re-monumented, recovered, found as expressed below:

NOTE: Not more than 4 corners, all in the same town and range, may be recorded on this certificate.

A. Description of original monument and accessories and/or subsequent restoration:

L-8	1831	GLO		Not Set
	1955-68	Williams & Works		Set and used "T" Iron
	1973	LCRC #606	VanKooten	1/2" Iron
		Fc. Post E. 15.94'	Basswood SW	19.94' Fc. Post NNE 34.82'
		Exxel Eng.		Iron per LCRC #606
	1993	LCRC #6749	Roon	1/2" Iron
		Guage edge E. rail West 48.02'		12" Tri. Elm S70°E 10.33'
		5" Maple S50°E 11.60'		8" Maple S15°E 26.95'

B. Description of corner evidence found and/or method applied in restoring or reestablishing corner:

L-8 Found Concrete Monument at the SW corner of "Nagel Industrial Plat" (Liber 79, Pg. 18) at the intersection of the W. & S. lines of the NE 1/4 of Sec. 24, T6N, R11W. Concrete Monument fits witnesses per LCRC #6749 (all wits. from LCRC #606 are gone) and measurements of adjoining plats. Said Concrete Monument is 0.5' S. & 0.2' E. from a true intersection of 1/4 lines.

The Concrete Monument is accepted by me and is generally accepted by professional surveyors as the best available evidence of the position of the corner.

P.A. 345 1990 KENT COUNTY


PEER APPROVED 11/17/94

CHAIRMAN Henry Huber

C. Description of monument for corner and accessories established to perpetuate locating the position of the corner:

L-8 Set Standard Kent County Monument in place of the Concrete Monument.

Guage edge East rail	S90°W	48.02'
Nail & MDSH tag N. side 12" Tri. Elm	S70°E	10.33'
Nail & MDSH tag SW side 6" Basswood	S50°E	11.60'
Nail & MDSH tag E. side 8" Elm	S15°E	26.95'

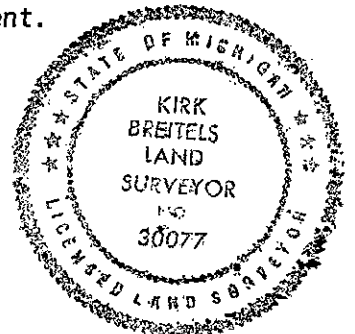

Signed by Kirk Breitels

Date 12/11/95

Surveyor's Michigan License No. 30077