

JAN 24 1996

KENT COUNTY REMONUMENTATION

COMMISSION

LAND CORNER RECORDATION CERTIFICATE

Filing Requirement of Act 74, Mich. P.A. 1970

\$7.00
\$2.00

For corners in
KENT COUNTY
(County)

Located In:

Corner Code #

1. Public Land Survey	T <u>6N</u> R <u>11W</u>	<u>L-10</u>
	T _____ R _____	_____
	T _____ R _____	_____
	T _____ R _____	_____
2. Property Controlling in Section	S _____ T _____ R _____	_____
	S _____ T _____ R _____	_____
3. Miscellaneous Property in Section	S _____ T _____ R _____	_____
	S _____ T _____ R _____	_____

REG. OF DEEDS

[Signature]

95 DEC 20 AM 8:40

STATE OF MICHIGAN
COUNTY OF KENT
RECEIVED FOR RECORD

8821

Register of Deeds Stamp & File Number

- 4. Lot No. _____, Recorded Plat _____
- 5. Private Claims _____

A	B	C	D	E	F	G	H	I	J	K	L	M
2	6	5	4	3	2	1						
3												
4	7	8	9	10	11	12						
5												
6	18	17	16	15	14	13						
7												
8	19	20	21	22	23	24						
9												
10	30	29	28	27	26	25						
11												
12	31	32	33	34	35	36						
13												

I, Kirk Breitels, in a field survey on Nov. 15, 1994

do hereby certify that under requirements of P.A. 74, Michigan P.A. of 1970, the corner points mentioned in lines 1 and 2 above were in conformance with regulations and rules therefore as required in the current manual of survey instructions of the United States Department of the Interior, Bureau of Land Management or by a decree of a Court of Law and/or that the corner points mentioned in lines 3, 4 and 5 above were in conformance with the rules of the Michigan Board of Professional Surveyors or by a Decree of a Court of Law; established, re-established, monumented, re-monumented, recovered, found as expressed below:

NOTE: Not more than 4 corners, all in the same town and range, may be recorded on this certificate.

A. Description of original monument and accessories and/or subsequent restoration:

- L-10 1831 GLO Not Set 1951-69 Williams & Works Set/used iron at "X" 1/4 lines
- 1961 Kent Co. Wit. Iron
- 6" Elm W. 26.9' 6" Elm N. 27.93' N-S fence E. 9.5'
- 1972 LCRC #201 & #239 Spicer 3/4" Iron
- Tw. 10" Ash S10°E 29.93' Tw. 10" Oak N10°W 46.05' 6" Oak N50°E 5.0'
- Exxel Eng. Used per LCRC #201
- 1993 LCRC #6767 Roon 1/2" Iron Pipe
- 4" Elm S80°E 8.05' Gauge edge W. rail East 27.30'
- 8" Maple East 88.32' 5" Poplar South 69.39'

B. Description of corner evidence found and/or method applied in restoring or reestablishing corner:


L-10 Found 1/2" Iron Pipe per witnesses from Kent Co. Wit. and LCRC's #201, #239, #6767. Said Iron is 0.3' E. & 0.6' S. from a true intersection of 1/4 lines and fits measurements by others.

The 1/2" Iron Pipe is accepted by me and is generally accepted by professional surveyors as the best available evidence of the position of the corner.

P.A. 345 1990 KENT COUNTY
PEER APPROVED 11/17/94
CHAIRMAN [Signature]

C. Description of monument for corner and accessories established to perpetuate locating the position of the corner:

- L-10 Set Standard Kent County Monument in place of the 1/2" Iron Pipe
- Nail & MDSH tag N. side 4" Elm S80°E 8.05'
- Gauge edge of West rail S90°E 27.30'
- Nail & MDSH tag N. side cluster 8" Elm S90°E 88.26'
- Nail & MDSH tag E. side 5" Poplar S00°E 69.39'
- Set Nail & KC Remon. tag E. side 8" Poplar N20°W 106.19'
- Set Nail & KC Remon. tag N. side 5" Oak S70°W 38.54'

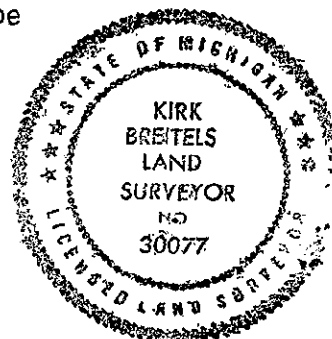

Signed by Kirk Breitels

Date 12/11/95

Surveyor's Michigan License No. 30077