SURVEY & REMONUMENTATION

APR 27 1995

COMMISSION

KENT COUNTY REMONUMENTATION

STATE OF MICHIGAN
COUNTY OF KENT
RECEIVED FOR RECORD
94 DEC -5 AM 9:01
REG. OF DEEDS

LAND CORNER RECORDATION CERTIFICATE

Filing Requirement of Act 74, Mich. P.A. 1970

For corners in KENT COUNTY (County)

	Located In:	Corner Code ##
1. Public Land Survey	T 6N R 11W	M-8
	T ___ R ___	
	T ___ R ___	
	T ___ R ___	
2. Property Controlling	S ___ T ___ R ___	
in Section	S ___ T ___ R ___	
3. Miscellaneous	S ___ T ___ R ___	
Property in Sec.	S ___ T ___ R ___	

7716

Register of Deeds Stamp & File Number

4. Lot No. _____, Recorded Plat _____
5. Private Claims _____

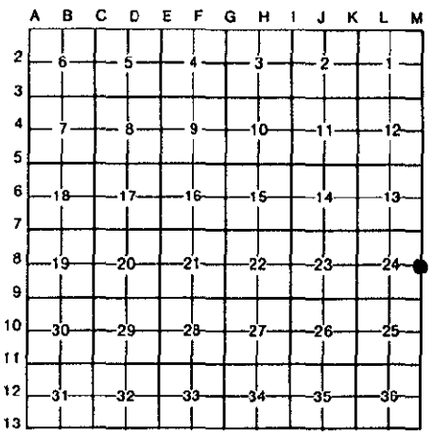

I, William R. Byl, *in a field survey on* Sept. 20, 19 94, do hereby certify that under requirements of P.A. 74, Michigan P.A. of 1970, the corner points mentioned in lines 1 and 2 above were in conformance with regulations and rules therefore as required in the current manual of survey instructions of the United States Department of the Interior, Bureau of Land Management or by a decree of a Court of Law and/or that the corner points mentioned in lines 3, 4 and 5 above were in conformance with the rules of the Michigan Board of Land Surveyors or by a Decree of a Court of Law; established, re-established, monumented, re-monumented, recovered, found as expressed below:

NOTE: Not more than 4 corners, all in the same town and range, may be recorded on this certificate.

A. Description of original monument and accessories and/or subsequent restoration:

M-8	1831	GLO	Mullett	Set Post
	1966	Kent Co. Wit.		1/2" Iron in mon. box
	1973	LCRC #606	VanKooten	Iron in mon. box
	1981	LCRC #2165	Jonker	Set Kent County Monument in mon. box
	1987	LCRC #4537	Bueche	Reset Kent Co. Mon. after road const.
	1989	LCRC #4987	Bueche	Kent County Monument

The position of this corner was previously approved by the Kent County Remonumentation Peer Group, monumented by Robert J. Jonker on 8/26/81 and was recorded per LCRC #2165

B. Description of corner evidence found and/or method applied in restoring or reestablishing corner:

M-8 Found standard Kent Co. Mon. (Harrison) per witnesses from above LCRC as set by John C. Bueche at the same position as set in 1981 by Robert J. Jonker in place of the Iron he found inside a mon. box. Said Iron checks with Kent Co. Wit. and LCRC #606.

LCRC #4537

"X" cut in curb	N30°E	63.68'
"X" cut in curb	N25°W	64.98'
"X" cut in sidewalk	S80°E	48.56'
NE cor. casting of CB	S30°E	72.87'
NW cor. casting of CB	S25°W	74.96'
KC Mon. North 11.48'		
Irons East & West 100.00' & 200.00'		
On C/L blacktop		

LCRC #4987

same witnesses as LCRC #4537

P.A. 345 1990 KENT COUNTY
PEER APPROVED 12/1/94
CHAIRMAN Harry Huber

The selected location is accepted by me and is generally accepted by professional surveyors as the best available evidence of the position of the original corner.

C. Description of monument for corner and accessories established to perpetuate locating the position of the corner:

M-8 Standard Kent County Monument

"X" cut in curb	N30°E	63.68'
"X" cut in curb	N25°W	64.98'
NE cor. casting of CB	S30°E	72.87'
NW cor. casting of CB	S25°W	74.96'
Top centerline hydrant	N20°W	121.23'
KC Mon. at A-8 T6N, R10W	N00°E	11.51'
On C/L blacktop		

Signed by W. R. Byl Date 112794

Surveyor's Michigan License No. 23502

STATE OF MICHIGAN
William R. Byl
Registered Land Surveyor
No. 23502

FORM APPROVED BY MICHIGAN STATE BOARD OF LAND SURVEYORS, JAN. 29, 1971
REVISED MAY 14, 1975
REVISED JAN., 1983