

SURVEY &

REMONUMENTATION

\$7.00 SEP 18 1995  
\$2.00 COMMISSION

KENT COUNTY REMONUMENTATION

LAND CORNER RECORDATION CERTIFICATE

Filing Requirement of Act 74, Mich. P.A. 1970

STATE OF MICHIGAN  
COUNTY OF KENT  
RECEIVED FOR RECORD

95 MAY 12 AM 10:43

For corners in  
KENT COUNTY  
(County)

Located In:

Corner Code #

- 1. Public Land Survey T 6N R 11W M-12  
T \_\_\_\_\_ R \_\_\_\_\_  
T \_\_\_\_\_ R \_\_\_\_\_  
T \_\_\_\_\_ R \_\_\_\_\_
- 2. Property Controlling S \_\_\_\_\_ T \_\_\_\_\_ R \_\_\_\_\_  
in Section S \_\_\_\_\_ T \_\_\_\_\_ R \_\_\_\_\_
- 3. Miscellaneous S \_\_\_\_\_ T \_\_\_\_\_ R \_\_\_\_\_  
Property in Sec. S \_\_\_\_\_ T \_\_\_\_\_ R \_\_\_\_\_

*W. J. Bond*  
REG. OF DEEDS

8350

Register of Deeds Stamp & File Number

- 4. Lot No. \_\_\_\_\_, Recorded Plat \_\_\_\_\_
- 5. Private Claims \_\_\_\_\_

A	B	C	D	E	F	G	H	I	J	K	L	M
2	6	5	4	3	2	1						
3												
4	7	8	9	10	11	12						
5												
6	18	17	16	15	14	13						
7												
8	19	20	21	22	23	24						
9												
10	30	29	28	27	26	25						
11												
12	31	32	33	34	35	36						
13												

Kirk Breitels March 6 95

I, \_\_\_\_\_, in a field survey on \_\_\_\_\_, 19\_\_\_\_, do hereby certify that under requirements of P.A. 74, Michigan P.A. of 1970, the corner points mentioned in lines 1 and 2 above were in conformance with regulations and rules therefore as required in the current manual of survey instructions of the United States Department of the Interior, Bureau of Land Management or by a decree of a Court of Law and/or that the corner points mentioned in lines 3, 4 and 5 above were in conformance with the rules of the Michigan Board of Land Surveyors or by a Decree of a Court of Law: established, re-established, monumented, re-monumented, recovered, found as expressed below:

NOTE: Not more than 4 corners, all in the same town and range, may be recorded on this certificate.

A. Description of original monument and accessories and/or subsequent restoration:

M-12	1831	GLO	Mullett	Set Post
	1972	LCRC 175	Spicer	1/2" Iron in Mon. Box
	1974	Kent Co. Wit.		Mon. Box
	1981	LCRC 2160	Jonker	Set Kent Co. Mon.
	1989	LCRC 4990	Beuche	Set Kent Co. Mon.

The position of this corner was previously approved by the Kent County Remonumentation Peer Group, monumented by Robert J. Jonker on 9/1/81 and was recorded per LCRC 2160.

B. Description of corner evidence found and/or method applied in restoring or reestablishing corner:

M-12 Found Rerod with Prien & Newhoff cap over Kent Co. Mon. 20" below ground. No witnesses remain from LCRC 175 or 2160. Fits one remaining witness from LCRC 4990. Fits dimensions and bearings of "MEADOWBROOK BUSINESS PARK," (Liber 91 Pages 21-31).

Nail & tag E. side 84" Oak N90°W 120.39'

The selected position is accepted by me and is generally accepted by professional surveyors as the best available evidence of the original corner.

P.A. 345 1990 KENT COUNTY


PEER APPROVED 3/30/95

CHAIRMAN *Harry Huber*

C. Description of monument for corner and accessories established to perpetuate locating the position of the corner:

M-12 Set Standard Kent County Monument in place of Rerod with Prien & Newhoff cap over previous Kent Co. Monument.

NW cor. CB header	N25°E	100.16'
SW cor. CB header	N40°E	53.72'
Conc. Mon. (leaning Westerly)	S90°E	27.36'
Nail & KC Remon. tag S. side 84" Oak	N90°W	120.50'
Nail & KC Remon. tag N. side P. Pole	N75°W	94.91'
SE cor. conc. blk. bldg.	S80°W	178.14'
NE cor. conc. blk. bldg.	N45°W	188.84'

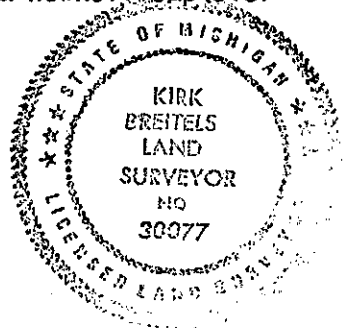

Signed by *Kirk Breitels*

Date 3/30/95

Surveyor's Michigan License No. 30077