SURVEY & REMONUMENTATION

MAY 28 1997

COMMISSION

LAND CORNER RECORDATION CERTIFICATE
Filing Requirement of Act 74, Mich. P.A. 1970

For corners in Kent County (County)

	Located In:	Corner Code #
1. Public Land Survey	T 6N R 11W	K-8
	T ___ R ___	
	T ___ R ___	
	T ___ R ___	
2. Property Controlling in Section	S ___ T ___ R ___	
	S ___ T ___ R ___	
3. Miscellaneous Property in Sec.	S ___ T ___ R ___	
	S ___ T ___ R ___	

STATE OF MICHIGAN
COUNTY OF KENT
RECEIVED FOR RECORD
96 NOV -7 AM 9:39
REG. OF DEEDS

9422

Register of Deeds Stamp & File Number

4. Lot No. _____ , Recorded Plat _____

5. Private Claims _____

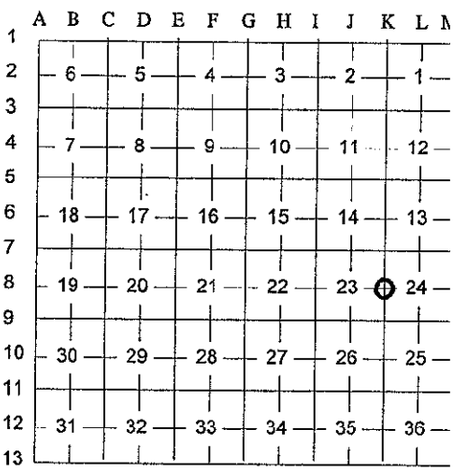

I, Arthur W. Brintnall, in a field survey on August 8, 19 96 do hereby state that under requirements of P.A. 74, Michigan P.A. of 1970, the corner points mentioned in lines 1 and 2 above were in conformance with regulations and rules therefore as required in the current manual of survey instructions of the United States Department of the Interior, Bureau of Land Management or by a decree of a Court of Law and/or that the corner points mentioned in lines 3, 4 and 5 above were in conformance with the rules of the Michigan Board of Land Surveyors or by a Decree of a Court of Law; established, re-established, monumented, recovered, found as expressed below:

NOTE: Not more than 2 corners, all in the same town and range, may be recorded on this certificate.

A. Description of original monument and accessories and/or subsequent restoration:

K-8	1831	GLO	Mullett	Set Post
	1961	Kent Co. Wit.		3/4" Iron
	1973	LCRC #527	Bonnema	1/4" Iron
	1973	LCRC #589	Spicer	1/2" Iron
	1981	LCRC #2031	Hackbardt	Set Kent County Monument
	1989	LCRC #4969	Bueche	Kent County Monument
	1993	LCRC #6749	Roon	Kent County Monument
	1994	LCRC #7697	Byl	Kent County Monument

The position of this corner was previously approved by the Kent County Remonumentation Peer Group, monumented by Glen S. Hackbardt on 6/11/81 and was recorded per LCRC #2031.

B. Description of corner evidence found and/or method applied in restoring or reestablishing corner:

K-8 Found Standard Kent Co. Mon. (Harrison) per following witness prior to road construction additional witnesses were taken.

LCRC #7697	Nail & KC Remon. tag S. side CP Pole	S85°E	49.94'
	Nail & KC Remon. tag S. side P. Pole	S45°W	52.72'
	New Nail & KC Remon. tag S. side P. Pole	N85°W	36.28'
	New Nail & KC Remon. tag SW side 22" Willow	N30°W	67.75'

The selected location is accepted by me and is generally accepted by professional surveyors as the best available evidence of the position of the original corner.

C. Description of monument for corner and accessories established to perpetuate locating the position of the corner:

K-8 Found broken off Standard Kent County Mon. after construction - reset new Kent Co. Mon.

Nail & Remon. tag S. side PP	S80°E	49.93'
Nail & Remon. tag NW side PP	S45°W	52.75'
Nail & Remon. tag S. side 14" Elm	S70°W	27.43'
Top CL Hyd	W	28.30'
SE corner of S end conc ret wall	N80°W	64.90'
Back of 5' conc sidewalk	S60°E	31.74'
CL stripe of East Paris Ave	S60°E	63.5'

STATE OF MICHIGAN
ARTHUR W. BRINTNALL
LAND SURVEYOR
No. 28407
LICENSED LAND SURVEYOR

Signed by Arthur W. Brintnall
Prein & Newhof

Date Nov. 1, 1996

Surveyor's Michigan License No. 28407

FORM APPROVED BY MICHIGAN STATE BOARD OF PROFESSIONAL SURVEYORS, JAN. 28, 1971
REVISED MAY 14, 1975
REVISED JAN., 1983
REVISED OCT., 1995