

# SURVEY & REMONUMENTATION

Kent County Remonumentation

APR 28 1995

STATE OF MICHIGAN  
COUNTY OF KENT  
RECEIVED FOR RECORD

94 NOV 29 AM 9:17

## COMMISSION

### LAND CORNER RECORDATION CERTIFICATE Filing Requirement of Act 74, Mich. P.A. 1970

For corners in  
Kent  
(County)

Located In:

Corner Code #/

- |                                       |                         |       |
|---------------------------------------|-------------------------|-------|
| 1. Public Land Survey                 | T 6N R 12W              | A-1   |
|                                       | T _____ R _____         | _____ |
|                                       | T _____ R _____         | _____ |
|                                       | T _____ R _____         | _____ |
| 2. Property Controlling in Section    | S _____ T _____ R _____ | _____ |
|                                       | S _____ T _____ R _____ | _____ |
| 3. Miscellaneous Property in Sec.     | S _____ T _____ R _____ | _____ |
|                                       | S _____ T _____ R _____ | _____ |
| 4. Lot No. _____, Recorded Plat _____ |                         |       |
| 5. Private Claims _____               |                         |       |

*Twigg Bond*  
REG. OF DEEDS

7386

Register of Deeds Stamp & File Number

A	B	C	D	E	F	G	H	I	J	K	L	M
2	6	5	4	3	2	1						
3												
4	7	8	9	10	11	12						
5												
6	18	17	16	15	14	13						
7												
8	19	20	21	22	23	24						
9												
10	30	29	28	27	26	25						
11												
12	31	32	33	34	35	36						
13												

I, Randy Kolehouse, in a field survey on March 25, 19 94, do hereby certify that under requirements of P.A. 74, Michigan P.A. of 1970, the corner points mentioned in lines 1 and 2 above were in conformance with regulations and rules therefore as required in the current manual of survey instructions of the United States Department of the Interior, Bureau of Land Management or by a decree of a Court of Law and/or that the corner points mentioned in lines 3, 4 and 5 above were in conformance with the rules of the Michigan Board of Land Surveyors or by a Decree of a Court of Law; established, re-established, monumented, re-monumented, recovered, found as expressed below:

**NOTE: Not more than 4 corners, all in the same town and range, may be recorded on this certificate.**

**A. Description of original monument and accessories and/or subsequent restoration:**

A-1	1831	G.L.O. Notes	L. Lyon	Set Post
	1953	Wit. Map		Stone
	1953	K.C. Surveyors Records		Stone
	1977	L.C.R.C. #1046	Williams & Works	1" Solid Iron
	1980	L.C.R.C. #1446		Set K.C. Monument
	1990	L.C.R.C. #5507		K.C. Monument

P.A. 345 1990 KENT COUNTY  
PEER APPROVED 8/11/94  
CHAIRMAN Harry Huber

The position of this corner was previously approved by the Kent County Remonumentation Peer Group monumented by Williams & Works on 10/24/80 and was recorded per L.C.R.C. #1446

**B. Description of corner evidence found and/or method applied in restoring or reestablishing corner:**

A-1 Found standard Kent County Monument 5' East of C/L Kenowa Ave. running N-S and 10' S of C/L Hall St. running E as set by Williams & Works in place of 1" solid iron and stone which they found using K.C.R.C. witness map and K.C. Surveyors records.


<p>L.C.R.C. #1446</p> <p>Nail &amp; K.C. remon. tag N side p. pole N 65° W 108.08'</p> <p>Nail &amp; K.C. remon. tag E side tele. pole N 35° W 67.54'</p> <p>On S edge of gravel road E &amp; near E edge of gravel road N &amp; S</p>	<p>L.C.R.C. #5507</p> <p>Nail &amp; K.C. remon. tag E side 16" Hackberry N 30° E 40.92'</p> <p>Nail &amp; K.C. remon. tag W side 18" Hackberry S 20° E 72.00'</p> <p>Nail &amp; K.C. remon. tag N side p. pole N 65° W 108.08'</p> <p>Nail &amp; K.C. remon. tag E side t. pole N 35° W 67.54'</p> <p>Nail &amp; K.C. remon. tag N side lt. pole S 75° W 31.19'</p> <p>On S edge of gravel road E and near E edge of gravel road N &amp; S</p>
--	--

The selected location is accepted by me and is generally accepted by professional surveyors as the best available evidence of the position of the original corner.

**C. Description of monument for corner and accessories established to perpetuate locating the position of the corner:**

A-1 Standard Kent County Monument

- Nail & K.C. remon. tag E side 16" Hackberry N 30° E 40.92'
- Nail & K.C. remon. tag W side 18" Hackberry S 20° E 72.00'
- Nail & K.C. remon. tag N side p. pole N 65° W 108.08'
- Nail & K.C. remon. tag E side t. pole N 35° W 67.54'
- Nail & K.C. remon. tag N side lt. pole S 75° W 31.19'
- 10' S of C/L Hall St. running E
- 5' E of C/L Kenowa Ave. running N-S

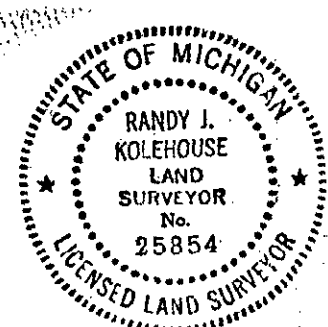

Signed by Randy J. Kolehouse  
Surveyor's Michigan License No. 25854

Date 11/21/94