

# SURVEY & REMONUMENTATION

Kent County Remonumentation

APR 28 1995

COMMISSION

LAND CORNER RECORDATION CERTIFICATE  
Filing Requirement of Act 74, Mich. P.A. 1970

STATE OF MICHIGAN  
COUNTY OF KENT  
RECEIVED FOR RECORD

94 NOV 29 AM 9:17

*W. J. Bond*  
REG. OF DEEDS

For corners in  
Kent

(County)	Located In:	Corner Code #
1. Public Land Survey	T <u>6N</u> R <u>12W</u>	<u>A-2</u>
	T _____ R _____	_____
	T _____ R _____	_____
	T _____ R _____	_____
2. Property Controlling in Section	S _____ T _____ R _____	_____
	S _____ T _____ R _____	_____
3. Miscellaneous Property in Sec.	S _____ T _____ R _____	_____
	S _____ T _____ R _____	_____

7387

Register of Deeds Stamp & File Number

4. Lot No. \_\_\_\_\_, Recorded Plat \_\_\_\_\_  
5. Private Claims \_\_\_\_\_

I, Randy Kolehouse, in a field survey on March 31, 19 94, do hereby certify that under requirements of P.A. 74, Michigan P.A. of 1970, the corner points mentioned in lines 1 and 2 above were in conformance with regulations and rules therefore as required in the current manual of survey instructions of the United States Department of the Interior, Bureau of Land Management or by a decree of a Court of Law and/or that the corner points mentioned in lines 3, 4 and 5 above were in conformance with the rules of the Michigan Board of Land Surveyors or by a Decree of a Court of Law; established, re-established, monumented, re-monumented, recovered, found as expressed below:

**NOTE: Not more than 4 corners, all in the same town and range, may be recorded on this certificate.**

	A	B	C	D	E	F	G	H	I	J	K	L	M
2	6	5	4	3	2	1							
3													
4	7	8	9	10	11	12							
5													
6	18	17	16	15	14	13							
7													
8	19	20	21	22	23	24							
9													
10	30	29	28	27	26	25							
11													
12	31	32	33	34	35	36							
13													

A. Description of original monument and accessories and/or subsequent restoration:

A-2 This corner was not originally set by the G.L.O.  
1953 Wit. Map K.C. Surveyor Iron  
1976 L.C.R.C. #1014 Nederveld "T" Iron  
1979 L.C.R.C. #1242 Shangraw Iron  
1982 L.C.R.C. #3171 Jonker R.R. Spike/T Iron/1/2" Iron/Plow Pt. Set K.C. Mon.

P.A. 345 1990 KENT COUNTY  
PEER APPROVED *11/1/94*  
CHAIRMAN *Harry Huber*

The position of this corner was previously approved by the Kent County Remonumentation Peer Group monumented by Jonker Land Surveys on 11/15/82 and was recorded per L.C.R.C. #3171.

B. Description of corner evidence found and/or method applied in restoring or reestablishing corner:

A-2 Found K.C. Monument in C/L Kenowa Ave. running N-S on C/L Riverbend Street running East as set by Rob Jonker in place of found R.R. spike over a "T" iron over a 1/2" iron over a plow point surrounded by stones which he found using K.C. Surveyor wits. and L.C.R.C. #'s #1014 & #1242.


L.C.R.C. #3171

NW corner hse. fndn. S 35° E 77.60'  
NE corner school fndn. N 60° W 163.11'  
Remon. tag NW side 26" Hickory N 60° E 54.02'  
Remon. tag, NW side 26" Maple S 30° W 86.72'  
On C/L N-S gravel, in line C/L pavt. to E

The selected location is accepted by me and is generally accepted by professional surveyors as the best available evidence of the position of the original corner.

C. Description of monument for corner and accessories established to perpetuate locating the position of the corner:

A-2 Standard Kent County Monument  
NW corner hse. fndn. S 35° E 77.60'  
NE corner school fndn. N 60° W 163.11'  
Nail & K.C. remon. tag NW side 26" Hickory N 60° E 54.02'  
Nail & K.C. remon. tag NW side 26" Maple S 30° W 86.72'  
On C/L N-S gravel, in line C/L pavt. to E

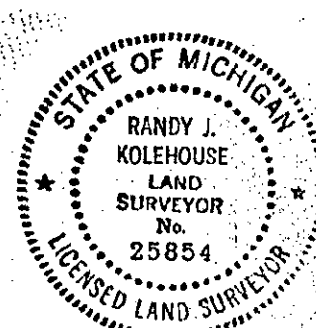

Signed by *Randy J. Kolehouse*  
Surveyor's Michigan License No. 25854

Date 11/21/94