

SURVEY & REMONUMENTATION

Kent County Remonumentation

STATE OF MICHIGAN
COUNTY OF KENT
RECEIVED FOR RECORD

APR 28 1995

LAND CORNER RECORDATION CERTIFICATE
Filing Requirement of Act 74, Mich. P.A. 1970

94 NOV 29 AM 9:17

COMMISSION

For corners in
Kent

(County)	Located In:	Corner Code #
1. Public Land Survey	T <u>6N</u> R <u>12W</u>	<u>A-4</u>
	T _____ R _____	_____
	T _____ R _____	_____
	T _____ R _____	_____
2. Property Controlling in Section	S _____ T _____ R _____	_____
	S _____ T _____ R _____	_____
3. Miscellaneous Property in Sec.	S _____ T _____ R _____	_____
	S _____ T _____ R _____	_____

Tim J. Bond
REG. OF DEEDS

7389

Register of Deeds Stamp & File Number

4. Lot No. _____, Recorded Plat _____
5. Private Claims _____

	A	B	C	D	E	F	G	H	I	J	K	L	M
2	6	5	4	3	2	1							
3													
4	7	8	9	10	11	12							
5													
6	18	17	16	15	14	13							
7													
8	19	20	21	22	23	24							
9													
10	30	29	28	27	26	25							
11													
12	31	32	33	34	35	36							
13													

I, Randy Kolehouse, in a field survey on June 30, 19 94, do hereby certify that under requirements of P.A. 74, Michigan P.A. of 1970, the corner points mentioned in lines 1 and 2 above were in conformance with regulations and rules therefore as required in the current manual of survey instructions of the United States Department of the Interior, Bureau of Land Management or by a decree of a Court of Law and/or that the corner points mentioned in lines 3, 4 and 5 above were in conformance with the rules of the Michigan Board of Land Surveyors or by a Decree of a Court of Law; established, re-established, monumented, re-monumented, recovered, found as expressed below:

NOTE: Not more than 4 corners, all in the same town and range, may be recorded on this certificate.

A. Description of original monument and accessories and/or subsequent restoration:

- A-4 This corner was not originally set by the G.L.O.
 ?? Wit. Map K.C. Surveyor Iron
 1972 L.C.R.C. #202 Williams & Works 1/2" Iron
 1982 L.C.R.C. #3172 Jonker "T" Iron Over 1/2" Iron/Set K.C. Monument

The position of this corner was previously approved by the Kent County Remonumentation Peer Group monumented by Jonker Land Surveys on 11/12/82 and was recorded per L.C.R.C. #3172.

B. Description of corner evidence found and/or method applied in restoring or reestablishing corner:

- A-4 Found K.C. Monument 2' East of the C/L of Kenowa Avenue running N-S per L.C.R.C. #3172 as set by Rob Jonker in place of a "T" Iron over a 1/2" iron he found using K.C. Surveyors wits. and L.C.R.C. #202.

L.C.R.C. #3172


Remon. tag S side 12" Ash S 75° E 66.28'
 Remon. tag NW side 9" Ash N 30° E 62.81'
 Remon. tag NW side 8" Ash S 50° W 43.74'
 C/L N-S gravel 2' W m/l

P.A. 345 1990 KENT COUNTY
 PEER APPROVED 8/11/94
 CHAIRMAN Randy Kolehouse

The selected location is accepted by me and is generally accepted by professional surveyors as the best available evidence of the position of the original corner.

C. Description of monument for corner and accessories established to perpetuate locating the position of the corner:

- A-4 Standard Kent County Monument
 Nail & K.C. remon. tag N side 12" Ash S 76° E 66.07'
 Nail & K.C. remon. tag NW side 10" Ash N 43° E 62.88'
 Nail & K.C. remon. tag NW side 10" Ash S 50° W 43.73'
 Nail & K.C. remon. tag SW side 10" Ash N 35° W 81.98'
 C/L N-S gravel 2' W m/l
 4' North to C/L 15" cmp. culvert

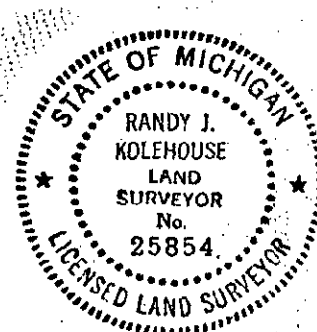

Signed by Randy J. Kolehouse
 Surveyor's Michigan License No. 25854

Date 11/21/94