

**SURVEY & REMONUMENTATION**

Kent County Remonumentation

STATE OF MICHIGAN  
COUNTY OF KENT  
RECEIVED FOR RECORD

APR 28 1995

LAND CORNER RECORDATION CERTIFICATE  
Filing Requirement of Act 74, Mich. P.A. 1970

94 NOV 29 AM 9:17

For corners in **COMMISSION**

Kent (County)	Located In:	Corner Code #:
1. Public Land Survey	T <u>6N</u> R <u>12W</u>	<u>A-5</u>
	T _____ R _____	_____
	T _____ R _____	_____
	T _____ R _____	_____
2. Property Controlling in Section	S _____ T _____ R _____	_____
	S _____ T _____ R _____	_____
3. Miscellaneous Property in Sec.	S _____ T _____ R _____	_____
	S _____ T _____ R _____	_____

*Twigg Bond*  
REG. OF DEEDS

7390

Register of Deeds Stamp & File Number

4. Lot No. \_\_\_\_\_, Recorded Plat \_\_\_\_\_  
5. Private Claims \_\_\_\_\_

	A	B	C	D	E	F	G	H	I	J	K	L	M
2	6	5	4	3	2	1							
3													
4	7	8	9	10	11	12							
5													
6	18	17	16	15	14	13							
7													
8	19	20	21	22	23	24							
9													
10	30	29	28	27	26	25							
11													
12	31	32	33	34	35	36							
13													

I, Randy Kolehouse, in a field survey on July 1, 19 94, do hereby certify that under requirements of P.A. 74, Michigan P.A. of 1970, the corner points mentioned in lines 1 and 2 above were in conformance with regulations and rules therefore as required in the current manual of survey instructions of the United States Department of the Interior, Bureau of Land Management or by a decree of a Court of Law and/or that the corner points mentioned in lines 3, 4 and 5 above were in conformance with the rules of the Michigan Board of Land Surveyors or by a Decree of a Court of Law; established, re-established, monumented, re-monumented, recovered, found as expressed below:

**NOTE: Not more than 4 corners, all in the same town and range, may be recorded on this certificate.**

A. Description of original monument and accessories and/or subsequent restoration:

A-5	1831	G.L.O. Notes	L. Lyon	Set Post
	??	Wit Map	K.C. Surveyor	Iron
	1979	Survey Records	Williams & Works	Iron
	1980	Survey Records	Medema Van Kooten	Iron
	1985	L.C.R.C. #4278	Rosema	Set K.C. Monuments

The position of this corner was previously approved by the Kent County Remonumentation Peer Group monumented by Maurice J. Rosema on 9/4/85 and was recorded per L.C.R.C. #4278.

B. Description of corner evidence found and/or method applied in restoring or reestablishing corner:

A-5 Found K.C. Monument as set by Maurice Rosema using survey records from Williams & Works and Medema Van Kooten Assoc. Checks witnesses L.C.R.C. #4278.

L.C.R.C. #4278


- Nail & remon tag W side 8" Ash S 20° E 39.99'
- Nail & remon tag S side 6" Ash S 86° E 14.49'
- Nail & remon tag SE side 15" Ash N 40° E 28.99'
- Nail & remon tag NE side 12" Poplar N 35° W 38.89'
- Nail & remon tag SW side 18" Ash N 40° W 53.46'

P.A. 345 1990 KENT COUNTY  
PEER APPROVED 8/11/94  
CHAIRMAN *[Signature]*

The selected location is accepted by me and is generally accepted by professional surveyors as the best available evidence of the position of the original corner.

C. Description of monument for corner and accessories established to perpetuate locating the position of the corner:

- A-5 Standard Kent County Monument
- Nail & K.C. remon. tag W side 8" Ash S 20° E 39.99'
  - Nail & K.C. remon. tag S side 6" Ash S 86° E 14.49'
  - Nail & K.C. remon. tag SE side 15" Ash N 40° E 28.99'
  - Nail & K.C. remon. tag NE side 12" Poplar N 35° W 38.89'
  - Nail & K.C. remon. tag SW side 18" Ash N 40° W 53.46'

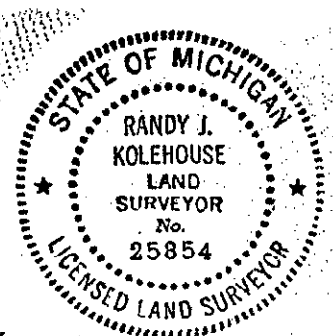

Signed by *[Signature]*  
Surveyor's Michigan License No. 25854

Date 11/21/94