

SURVEY & REMONUMENTATION

Kent County Remonumentation

STATE OF MICHIGAN
COUNTY OF KENT
RECEIVED FOR RECORD

APR 28 1995

LAND CORNER RECORDATION CERTIFICATE
Filing Requirement of Act 74, Mich. P.A. 1970

94 NOV 29 AM 9:17

For corners in Kent

COMMISSION

Tim J. Dand
REG. OF DEEDS

Located In:	Corner Code #
1. Public Land Survey T <u>6N</u> R <u>12W</u>	<u>A-6</u>
T _____ R _____	_____
T _____ R _____	_____
T _____ R _____	_____
2. Property Controlling in Section S _____ T _____ R _____	_____
S _____ T _____ R _____	_____
3. Miscellaneous Property in Sec. S _____ T _____ R _____	_____
S _____ T _____ R _____	_____

7391

Register of Deeds Stamp & File Number

4. Lot No. _____, Recorded Plat _____
5. Private Claims _____

	A	B	C	D	E	F	G	H	I	J	K	L	M
2	6	5	4	3	2	1							
3													
4	7	8	9	10	11	12							
5													
6	13	17	16	15	14	13							
7													
8	19	20	21	22	23	24							
9													
10	30	29	28	27	26	25							
11													
12	31	32	33	34	35	36							
13													

I, Randy Kolehouse, in a field survey on March 25, 1994

do hereby certify that under requirements of P.A. 74, Michigan P.A. of 1970, the corner points mentioned in lines 1 and 2 above were in conformance with regulations and rules therefore as required in the current manual of survey instructions of the United States Department of the Interior, Bureau of Land Management or by a decree of a Court of Law and/or that the corner points mentioned in lines 3, 4 and 5 above were in conformance with the rules of the Michigan Board of Land Surveyors or by a Decree of a Court of Law; established, re-established, monumented, re-monumented, recovered, found as expressed below:

NOTE: Not more than 4 corners, all in the same town and range, may be recorded on this certificate.

A. Description of original monument and accessories and/or subsequent restoration:

A-6 This corner was not originally set by the G.L.O.

1959	Wit. Map	K.C. Surveyor	Stone
1963	Survey Records	MDOT	Stone/with "x"
1980	L.C.R.C.	Williams & Works	End Stone/Set K.C. Monument

The position of this corner was previously approved by the Kent County Remonumentation Peer Group monumented by Williams & Works on 10/30/80 and was recorded per L.C.R.C. #1471.

B. Description of corner evidence found and/or method applied in restoring or reestablishing corner:

A-6 Found K.C. Monument per L.C.R.C. #1471 as set by Williams & Works in place of a stone with "+" cut which they found using K.C. Surveyors records and MDSH wits.

L.C.R.C. #1471


- NE cor. garage (frame) S 05° E 135.17'
- NE cor. shed (frame) S 40° W 99.16'
- Nail & K.C.R. tag in N side 20" Crab Apple S 70° W 7.00'
- Nail & K.C.R. tag in E side 8" crab apple N 05° W 25.09'
- Nail & K.C.R. tag in W side tel. pole N 20° E 55.97'
- Nail & K.C.R. tag in N side 10" Ash S 75° E 27.88'

P.A. 345 1990 KENT COUNTY
PEER APPROVED 9/22/94
CHAIRMAN *Harry Super*

The selected location is accepted by me and is generally accepted by professional surveyors as the best available evidence of the position of the original corner.

C. Description of monument for corner and accessories established to perpetuate locating the position of the corner:

- A-6 Standard Kent County Monument
- NE cor. garage (frame) S 00° E 135.40'
- NE cor. shed (frame) S 45° W 99.26'
- Nail & K.C. remon. tag in N side 20" Crab Apple S 65° W 6.85'
- Nail & K.C. remon. tag in E side 8" Crab Apple N 05° W 25.09'
- Nail & K.C. remon. tag in W side tel. pole N 20° E 55.90'
- Nail & K.C. remon. tag in N side 10" Ash S 75° E 27.36'

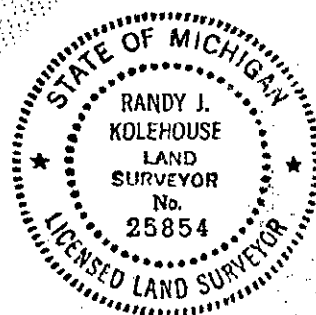

Signed by *Randy J. Kolehouse*
Surveyor's Michigan License No. 25854

Date 11/21/94