

# SURVEY & REMONUMENTATION

Kent County Remonumentation

STATE OF MICHIGAN  
COUNTY OF KENT  
RECEIVED FOR RECORD

APR 28 1995

## LAND CORNER RECORDATION CERTIFICATE Filing Requirement of Act 74, Mich. P.A. 1970

94 NOV 29 AM 9:17

For corners of **COMMISSION**  
Kent  
(County)

*Tim J. Bond*  
REG. OF DEEDS

	Located In:	Corner Code #
1. Public Land Survey	T <u>6N</u> R <u>12W</u>	<u>A-7</u>
	T _____ R _____	_____
	T _____ R _____	_____
	T _____ R _____	_____
2. Property Controlling in Section	S _____ T _____ R _____	_____
	S _____ T _____ R _____	_____
3. Miscellaneous Property in Sec.	S _____ T _____ R _____	_____
	S _____ T _____ R _____	_____

**7392**  
Register of Deeds Stamp & File Number

4. Lot No. \_\_\_\_\_, Recorded Plat \_\_\_\_\_  
5. Private Claims \_\_\_\_\_

	A	B	C	D	E	F	G	H	I	J	K	L	M
2	6	5	4	3	2	1							
3													
4	7	8	9	10	11	12							
5													
6	16	17	16	15	14	13							
7													
8	19	20	21	22	23	24							
9													
10	30	29	28	27	26	25							
11													
12	31	32	33	34	35	36							
13													

I, Randy Kolehouse, in a field survey on March 25, 1994

do hereby certify that under requirements of P.A. 74, Michigan P.A. of 1970, the corner points mentioned in lines 1 and 2 above were in conformance with regulations and rules therefore as required in the current manual of survey instructions of the United States Department of the Interior, Bureau of Land Management or by a decree of a Court of Law and/or that the corner points mentioned in lines 3, 4 and 5 above were in conformance with the rules of the Michigan Board of Land Surveyors or by a Decree of a Court of Law; established, re-established, monumented, re-monumented, recovered, found as expressed below:

**NOTE: Not more than 4 corners, all in the same town and range, may be recorded on this certificate.**

**A. Description of original monument and accessories and/or subsequent restoration:**

A-7	1831	G.L.O. Notes	L. Lyon	Set Post	P.A. 345 1990 KENT COUNTY PEER APPROVED <u>7/28/94</u> CHAIRMAN <u>[Signature]</u>
	N/A	Wit. Map	K.C. Surveyor	Monument	
	1965	Survey Records	MDSH	Iron	
	1972	L.C.R.C. #436	Medema Van Kooten	Conc. Monument	
	1982	L.C.R.C. #3173	Jonker	Fnd. Iron & Mon./Set K.C. Mon.	
	1987	L.C.R.C. #4538	Bueche	Reset K.C. Mon.	
	1988	L.C.R.C. #4909	Bueche	K.C. Mon.	

This corner was originally approved by the Kent County Remonumentation Peer Group and monumented by Rob Jonker on 1/16/82 and was recorded per L.C.R.C. #3173.

**B. Description of corner evidence found and/or method applied in restoring or reestablishing corner:**

A-7 Found K.C. Monument in C/L of Kenawa Avenue N-S of C/L 36th Street E-W per L.C.R.C.'s #3173, #4538 and #4909 as reset by John Bueche after street construction at the location of a K.C. Monument set by Rob Jonker in place of a 1" rod he found over the top of a concrete monument which checked K.C. surveyor's records and L.C.R.C. #436.


<b>L.C.R.C. #4538</b>	<b>L.C.R.C. #4909</b>
SE cor. hse. fnd. N 45° W 75.40'	SE cor. hse. fnd. N 45° W 75.40'
NE cor. hse. fnd. S 40° W 110.00'	NE cor. hse. fnd. S 40° W 110.00'
NW cor. hse. fnd. S 40° E 115.68'	NW cor. hse. fnd. S 40° E 115.68'
P.K. nail N. side p. pole N 40° E 58.37'	P.K. nail N. side p. pole N 40° E 58.37'
SE cor. bot. conc. step to hse. #7211 Kenowa N 42° W 73.53'	SE cor. bot. conc. step to hse. #7211 Kenowa N 42° W 73.53'
Centerline of road N-S, E-W	Centerline of road N-S, E-W

The selected location is accepted by me and is generally accepted by professional surveyors as the best available evidence of the position of the original corner.

**C. Description of monument for corner and accessories established to perpetuate locating the position of the corner:**

A-7 Standard Kent County Monument  
SE cor. hse. fnd. N 45° W 75.40'  
NE cor. hse. fnd. S 40° W 110.00'  
NW cor. hse. fnd. S 40° E 115.68'  
P.K. nail N. side p. pole N 40° E 58.37'  
SE cor. bot. conc. step to hse. #7211 Kenowa N 42° W 73.53'  
Centerline of road N-S, E-W

This corner is common with M-7, T6N, R13W.

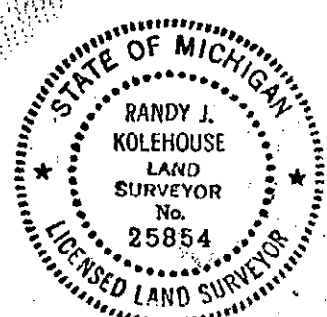

Signed by Randy J. Kolehouse  

Date 11/21/94