

SURVEY & REMONUMENTATION

Kent County Remonumentation

STATE OF MICHIGAN
COUNTY OF KENT
RECEIVED FOR RECORD

APR 28 1995

LAND CORNER RECORDATION CERTIFICATE Filing Requirement of Act 74, Mich. P.A. 1970

94 NOV 29 AM 9:17

For corners in **COMMISSION**

Tim J. Gland
REG. OF DEEDS

For corners in Kent (County)	Located In:	Corner Code #
1. Public Land Survey	T <u>6N</u> R <u>12W</u>	A-8
	T _____ R _____	_____
	T _____ R _____	_____
	T _____ R _____	_____
2. Property Controlling in Section	S _____ T _____ R _____	_____
	S _____ T _____ R _____	_____
3. Miscellaneous Property in Sec.	S _____ T _____ R _____	_____
	S _____ T _____ R _____	_____

7393

Register of Deeds Stamp & File Number

4. Lot No. _____, Recorded Plat _____
5. Private Claims _____

	A	B	C	D	E	F	G	H	I	J	K	L	M
2	6	5	4	3	2	1							
3													
4	7	8	9	10	11	12							
5													
6	18	17	16	15	14	13							
7													
8	19	20	21	22	23	24							
9													
10	30	29	28	27	26	25							
11													
12	31	32	33	34	35	36							
13													

I, Randy Kolehouse, in a field survey on March 25, 1994, do hereby certify that under requirements of P.A. 74, Michigan P.A. of 1970, the corner points mentioned in lines 1 and 2 above were in conformance with regulations and rules therefore as required in the current manual of survey instructions of the United States Department of the Interior, Bureau of Land Management or by a decree of a Court of Law and/or that the corner points mentioned in lines 3, 4 and 5 above were in conformance with the rules of the Michigan Board of Land Surveyors or by a Decree of a Court of Law; established, re-established, monumented, re-monumented, recovered, found as expressed below:

NOTE: Not more than 4 corners, all in the same town and range, may be recorded on this certificate.

A. Description of original monument and accessories and/or subsequent restoration:

A-8	This corner was not originally set by G.L.O.			
1942	Wit. Map	K.C. Surveyor	Iron	
1965	Wit. Map	K.C. Surveyor	Iron	
1966	Survey Records	MSHD	Iron	
1974	L.C.R.C. #761	Exxel Engineering	1/4" Rebar	
1984	L.C.R.C. #3931	Rosema	Fnd. 1/2" Iron/Set K.C. Mon	
1988	L.C.R.C. #4910	Bueche	K.C. Monument	

P.A. 345 1990 KENT COUNTY
PEER APPROVED 7/28/94
CHAIRMAN *Maurice Rosema*

This corner was originally approved by the Kent County Remonumentation Peer Group and monumented by Maurice Rosema on 10/18/84 and was recorded per L.C.R.C. #3931.

B. Description of corner evidence found and/or method applied in restoring or reestablishing corner:

A-8 Found K.C. Monument in the C/L of Kenowa Avenue N-S per L.C.R.C.'s #3931 & #4910 as set by Maurice Rosema in place of a 1/2" rebar he found which checked the 1953 Williams & Works survey records, 1965 MSHD records & L.C.R.C. #761.

L.C.R.C. #3931

L.C.R.C. #4910


SW cor. brick hse. (at ground) N 75° E 116.40'
NE cor. brick hse. (at ground) S 82° W 122.52'
Nail & K.C. remon. tag in SE side 8" Pine N 23° E 118.03'
Nail & K.C. remon. tag in S. side Tw. 6" Elm N 56° W 32.85'
Nail & K.C. remon. tag in E. side Tri. 15" Maple S 18° W 116.88'
3/4" Iron MB, T6N, R13W, N 17.98'

SW cor. brick hse. (at ground) N 75° E 116.40'
NE cor. brick hse. (at ground) S 82° W 122.52'
Nail & K.C. remon. tag in SE side 8" Pine N 23° E 118.03'
Nail & K.C. remon. tag in S. side Tw. 6" Elm N 56° W 32.85'
Nail & K.C. remon. tag in E. side Tri. 15" Maple S 18° W 116.88'
3/4" Iron MB, T6N, R13W, N 17.98'

The selected location is accepted by me and is generally accepted by professional surveyors as the best available evidence of the position of the original corner.

C. Description of monument for corner and accessories established to perpetuate locating the position of the corner:

A-8 Standard Kent County Monument
SW cor. brick hse. (at ground) N 75° E 116.40'
NE cor. brick hse. (at ground) S 82° W 122.52'
Nail & K.C. remon. tag in SE side 8" Pine N 23° E 118.03'
Nail & K.C. remon. tag in S. side Tw. 6" Elm N 56° W 32.85'
Nail & K.C. remon. tag in E. side Tri. 15" Maple S 18° W 116.88'
3/4" Iron MB, Section 24, T6N, R13W, N 17.98'

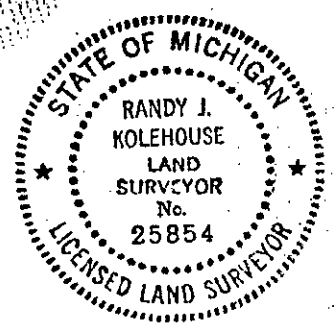

Signed by Randy J. Kolehouse

Date 11/21/94

Surveyor's Michigan License No. 25854