SURVEY & REMONUMENTATION

APR 28 1995

COMMISSION

Kent County Remonumentation

STATE OF MICHIGAN
COUNTY OF KENT
RECEIVED FOR RECORD

94 NOV 29 AM 9:17

REG. OF DEEDS

**LAND CORNER RECORDATION CERTIFICATE**
**Filing Requirement of Act 74, Mich. P.A. 1970**

For corners in

Kent (County)

| | Located In: | Corner Code ## |
|---|---|---|
| 1. Public Land Survey | T ____ R ____ | |
| | T 6N R 12W | A-9 |
| | T ____ R ____ | |
| | T ____ R ____ | |
| 2. Property Controlling | S ____ T ____ R ____ | |
| in Section | S ____ T ____ R ____ | |
| 3. Miscellaneous | S ____ T ____ R ____ | |
| Property in Sec. | S ____ T ____ R ____ | |

7394

**Register of Deeds Stamp & File Number**

4. Lot No. _____ , Recorded Plat _____
5. Private Claims _____

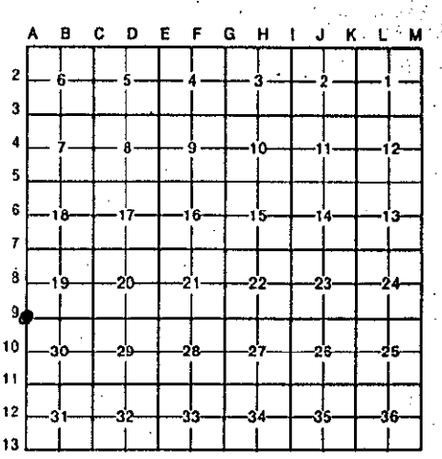


I, Randy Kolehouse, in a field survey on March 25, 19 94, do hereby certify that under requirements of P.A. 74, Michigan P.A. of 1970, the corner points mentioned in lines 1 and 2 above were in conformance with regulations and rules therefore as required in the current manual of survey instructions of the United States Department of the Interior, Bureau of Land Management or by a decree of a Court of Law and/or that the corner points mentioned in lines 3, 4 and 5 above were in conformance with the rules of the Michigan Board of Land Surveyors or by a Decree of a Court of Law; established, re-established, monumented, re-monumented, recovered, found as expressed below:

**NOTE: Not more than 4 corners, all in the same town and range, may be recorded on this certificate.**

A. Description of original monument and accessories and/or subsequent restoration:

| | | | | |
|---|---|---|---|---|
| A-9 | 1831 | G.L.O. Notes | L. Lyon | Set Post |
| | 1942 | Wit. Map | K.C. Surveyor | Monument |
| | 1947 | Survey Records | Williams & Works | Monument |
| | 1965 | Survey Records | MSHD | Iron |
| | 1971 | L.C.R.C. #177 | Williams & Works | 3/4" Iron |
| | 1984 | L.C.R.C. #3932 | Rosema | Fnd. Iron & Mon./Set K.C. Mon. |
| | 1988 | L.C.R.C. #4911 | Bueche | K.C. Mon |

P.A. 345 1990 KENT COUNTY
PEER APPROVED 7/28/94
CHAIRMAN

This corner was originally approved by the Kent County Remonumentation Peer Group and monumented by Maurice Rosema on 10/9/84 and was recorded per L.C.R.C. #3932.

B. Description of corner evidence found and/or method applied in restoring or reestablishing corner:

A-9 Found K.C. Monument in C/L Kenowa Avenue N-S on C/L 44th Street E-W per L.C.R.C.'s 3932 & #4911 as set by Maurice Rosema in place of a 3/4" iron he found over the top of a concrete monument which checked K.C. Surveyors and Williams & Works records along with L.C.R.C. #177.

| L.C.R.C. #3932 | L.C.R.C. #4911 |
|---|---|
| Nail & K.C. remon. tag in guy pole S 40° W 68.32' | Nail & K.C. remon. tag in guy pole S 40° W 68.32' |
| Nail & K.C. remon. tag in p. pole N 25° E 82.25' | |

The selected location is accepted by me and is generally accepted by professional surveyors as the best available evidence of the position of the original corner.

C. Description of monument for corner and accessories established to perpetuate locating the position of the corner:

A-9 Standard Kent County Monument
Nail & K.C. remon. tag in guy pole S 40° W 68.32'
Nail & K.C. remon. tag in NW side p. pole N 27° E 82.15'
Rebar with cap N 27.67' (SW corner Section 24, T6N, R13W)
"X" cut in top conc. curb S 22° E 56.63'

STATE OF MICHIGAN
RANDY J. KOLEHOUSE
LAND SURVEYOR
No. 25854
LICENSED LAND SURVEYOR

Signed by Randy J Kolehouse Date 11/21/94

Surveyor's Michigan License No. 25854

FORM APPROVED BY MICHIGAN STATE BOARD OF LAND SURVEYORS, JAN. 28, 1971
REVISED MAY 14, 1975
REVISED JAN., 1983