

SURVEY & REMONUMENTATION Kent County Remonumentation

STATE OF MICHIGAN
COUNTY OF KENT
RECEIVED FOR RECORD

APR 28 1995

LAND CORNER RECORDATION CERTIFICATE
Filing Requirement of Act 74, Mich. P.A. 1970

NOV 29 AM 9:17

For corners in
Kent

COMMISSION

Tim J. Bond
REG. OF DEEDS

| Located In: | Corner Code-# |
|---|---------------|
| 1. Public Land Survey T <u>6N</u> R <u>12W</u> | <u>A-11</u> |
| T _____ R _____ | _____ |
| T _____ R _____ | _____ |
| T _____ R _____ | _____ |
| 2. Property Controlling S _____ T _____ R _____ | _____ |
| in Section S _____ T _____ R _____ | _____ |
| 3. Miscellaneous S _____ T _____ R _____ | _____ |
| Property in Sec. S _____ T _____ R _____ | _____ |

7396

Register of Deeds Stamp & File Number

4. Lot No. _____, Recorded Plat _____
5. Private Claims _____

| | A | B | C | D | E | F | G | H | I | J | K | L | M |
|----|----|----|----|----|----|----|---|---|---|---|---|---|---|
| 2 | 6 | 5 | 4 | 3 | 2 | 1 | | | | | | | |
| 3 | | | | | | | | | | | | | |
| 4 | 7 | 8 | 9 | 10 | 11 | 12 | | | | | | | |
| 5 | | | | | | | | | | | | | |
| 6 | 18 | 17 | 16 | 15 | 14 | 13 | | | | | | | |
| 7 | | | | | | | | | | | | | |
| 8 | 19 | 20 | 21 | 22 | 23 | 24 | | | | | | | |
| 9 | | | | | | | | | | | | | |
| 10 | 30 | 29 | 28 | 27 | 26 | 25 | | | | | | | |
| 11 | | | | | | | | | | | | | |
| 12 | 31 | 32 | 33 | 34 | 35 | 36 | | | | | | | |
| 13 | | | | | | | | | | | | | |

I, Randy Kolehouse, in a field survey on April 1, 19 94, do hereby certify that under requirements of P.A. 74, Michigan P.A. of 1970, the corner points mentioned in lines 1 and 2 above were in conformance with regulations and rules therefore as required in the current manual of survey instructions of the United States Department of the Interior, Bureau of Land Management or by a decree of a Court of Law and/or that the corner points mentioned in lines 3, 4 and 5 above were in conformance with the rules of the Michigan Board of Land Surveyors or by a Decree of a Court of Law; established, re-established, monumented, re-monumented, recovered, found as expressed below:

NOTE: Not more than 4 corners, all in the same town and range, may be recorded on this certificate.

A. Description of original monument and accessories and/or subsequent restoration:

| | | | | |
|------|------|----------------|------------------|------------------------------|
| A-11 | 1831 | G.L.O. Notes | L. Lyon | Set Post |
| | 1966 | K.C.R.C. | Witness Map | Concrete Monument |
| | 1972 | L.C.R.C.#243 | Williams & Works | Iron |
| | 1975 | L.C.R.C.#807 | Moore & Bruggink | Iron |
| | 1982 | L.C.R.C. #3174 | Rob Jonker | Found Iron/Set K.C. Monument |

The position of this corner was previously approved by the Kent County Remonumentation Peer Group and monumented by Jonker Land Surveys on 12/17/82 and was recorded per L.C.R.C. #3174

B. Description of corner evidence found and/or method applied in restoring or reestablishing corner:

A-11 Found K.C. Monument in C/L Kenowa Avenue running N-S per L.C.R.C. #3174 as set by Rob Jonker in place of a P.K. nail over a 3/4" iron and yellow bricks using L.C.R.C.'s #243 & #3174.

L.C.R.C. #3174

K.C. remon. tag on SW side p. pole S 35° E 65.99'
C/L top of hydrant N 30° E 60.05'
On line to West
C/L N-S part. 2' E ML

P.A. 345 1990 KENT COUNTY


PEER APPROVED 7/28/94

CHAIRMAN *Randy Kolehouse*

The selected location is accepted by me and is generally accepted by professional surveyors as the best available evidence of the position of the original corner.

C. Description of monument for corner and accessories established to perpetuate locating the position of the corner:

A-11 Standard Kent County Monument
C/L top of hydrant N 30° E 65.05'
Nail & K.C. remon tag in N side 10" Hickory West 26.50'
Nail & K.C. remon. tag in E side 12" Elm N 20° W 63.08'
Nail & K.C. remon. tag in SW side p. pole S 35° E 65.99'

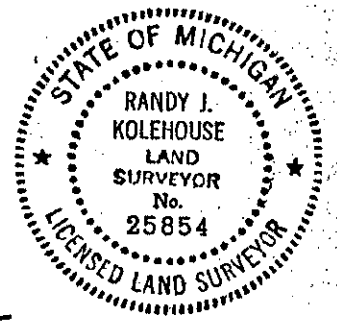

Signed by Randy J. Kolehouse

Date 11/21/94

Surveyor's Michigan License No. 25854