

**SURVEY & REMONUMENTATION**

Kent County Remonumentation

STATE OF MICHIGAN  
COUNTY OF KENT  
RECEIVED FOR RECORD

APR 28 1995

**LAND CORNER RECORDATION CERTIFICATE**  
Filing Requirement of Act 74, Mich. P.A. 1970

94 NOV 29 AM 9:17

For corners in  
Kent

**COMMISSION**

Located In:

Corner Code #

*W. J. Land*  
REG. OF DEEDS

- 1. Public Land Survey T 6N R 12W A-13
- T \_\_\_\_\_ R \_\_\_\_\_
- T \_\_\_\_\_ R \_\_\_\_\_
- T \_\_\_\_\_ R \_\_\_\_\_
- 2. Property Controlling S \_\_\_\_\_ T \_\_\_\_\_ R \_\_\_\_\_  
in Section S \_\_\_\_\_ T \_\_\_\_\_ R \_\_\_\_\_
- 3. Miscellaneous S \_\_\_\_\_ T \_\_\_\_\_ R \_\_\_\_\_  
Property in Sec. S \_\_\_\_\_ T \_\_\_\_\_ R \_\_\_\_\_
- 4. Lot No. \_\_\_\_\_, Recorded Plat \_\_\_\_\_
- 5. Private Claims \_\_\_\_\_

*Seg. 1*

7398

Register of Deeds Stamp & File Number

I, Randy Kolehouse, in a field survey on March 25, 19 94, do hereby certify that under requirements of P.A. 74, Michigan P.A. of 1970, the corner points mentioned in lines 1 and 2 above were in conformance with regulations and rules therefore as required in the current manual of survey instructions of the United States Department of the Interior, Bureau of Land Management or by a decree of a Court of Law and/or that the corner points mentioned in lines 3, 4 and 5 above were in conformance with the rules of the Michigan Board of Land Surveyors or by a Decree of a Court of Law; established, re-established, monumented, re-monumented, recovered, found as expressed below:

A	B	C	D	E	F	G	H	I	J	K	L	M
2	6	5	4	3	2	1						
3												
4	7	8	9	10	11	12						
5												
6	18	17	16	15	14	13						
7												
8	19	20	21	22	23	24						
9												
10	30	29	28	27	26	25						
11												
12	31	32	33	34	35	36						
13												

**NOTE: Not more than 4 corners, all in the same town and range, may be recorded on this certificate.**

**A. Description of original monument and accessories and/or subsequent restoration:**

A-13	1831	G.L.O. Notes	L. Lyon	Set Post
	1953	Survey Notes	Williams & Works	Iron/Stone
	1972	L.C.R.C. #152	Medema Van Kooten	3/4" Iron
	1981	L.C.R.C. #1548	Nederveld & Jonker	Fnd. Iron & Stone/Set K.C. Monument
	1990	L.C.R.C. #5700	John Bueche	K.C. Monument

P.A. 345 1990 KENT COUNTY  
PEER APPROVED 11/28/94  
CHAIRMAN W. J. Land

This corner was originally approved by the Kent County Remonumentation Peer Group monumented by Jonker Land Surveys on 2/14/81 and was recorded per L.C.R.C. #1548.

**B. Description of corner evidence found and/or method applied in restoring or reestablishing corner:**

A-13 Found K.C. Monument in C/L Kenowa Avenue running N-S and 60th Street running E-W per L.C.R.C. #1548 as set by Rob Jonker in place of a 3/4" iron and stone found using K.C. wit. map and L.C.R.C. 152.

L.C.R.C. #1548

L.C.R.C. #5700

- Nail & remon. tag on E side p. pole NNE 104.46'
- Nail & remon. tag on N side p. pole SE 50.2'
- Nail & remon. tag on SW side 8" Poplar NW 90.7'
- Nail & remon. tag on W cor. fence post SW 50.03'
- Nail & remon. tag on S side 6" Poplar WNW 110.48'
- On C/L N-S B.T., C/L to E is 4' S, C/L to W is 12' S
- Common corner to 4 Townships


- Nail & remon. tag on E side p. pole N 15° E 104.46'
- Nail & remon. tag on N side p. pole S 50° E 50.20'
- New nail & remon. tag on SW side 12" Poplar N 55° W 90.80'
- New nail & remon. tag on S side 10" Poplar N 75° W 110.50'
- NE cor. frame garage S 55° W 110.45'
- On C/L blacktop N-S & W, C/L East is South 4' ±

The selected location is accepted by me and is generally accepted by professional surveyors as the best available evidence of the position of the original corner.

**C. Description of monument for corner and accessories established to perpetuate locating the position of the corner:**

A-13 Standard Kent County Monument

- Nail & remon. tag on E side p. pole N 15° E 104.46'
- Nail & remon tag on N side p. pole S 50° E 50.20'
- New nail & remon. tag on SW side 12" Poplar N 55° W 90.80'
- New nail & remon. tag on S side 10" Poplar N 75° W 110.50'
- NE cor. frame garage S 55° W 110.45'

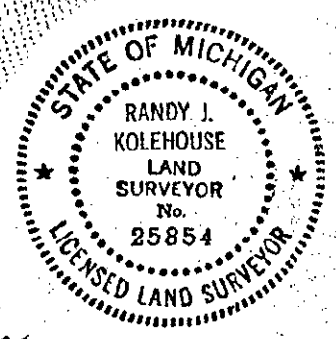

Signed by Randy J. Kolehouse  
Surveyor's Michigan License No. 25854

Date 11/21/94