

SURVEY & REMONUMENTATION

Kent County Remonumentation

STATE OF MICHIGAN
COUNTY OF KENT
RECEIVED FOR RECORD

APR 28 1995

LAND CORNER RECORDATION CERTIFICATE
Filing Requirement of Act 74, Mich. P.A. 1970

94 NOV 29 AM 9:18

COMMISSION

For corners in Kent

Located In:	Corner Code #
1. Public Land Survey T <u>6N</u> R <u>12W</u>	<u>B-1</u>
T _____ R _____	_____
T _____ R _____	_____
T _____ R _____	_____
2. Property Controlling in Section S _____ T _____ R _____	_____
S _____ T _____ R _____	_____
3. Miscellaneous Property in Sec. S _____ T _____ R _____	_____
S _____ T _____ R _____	_____

W. J. Bond
REG. OF DEEDS

7399

Register of Deeds Stamp & File Number

4. Lot No. _____, Recorded Plat _____
5. Private Claims _____

	A	B	C	D	E	F	G	H	I	J	K	L	M
2	6	5	4	3	2	1							
3													
4	7	8	9	10	11	12							
5													
6	18	17	16	15	14	13							
7													
8	19	20	21	22	23	24							
9													
10	30	29	28	27	26	25							
11													
12	31	32	33	34	35	36							
13													

I, Randy Kolehouse, in a field survey on July 18, 19 94, do hereby certify that under requirements of P.A. 74, Michigan P.A. of 1970, the corner points mentioned in lines 1 and 2 above were in conformance with regulations and rules therefore as required in the current manual of survey instructions of the United States Department of the Interior, Bureau of Land Management or by a decree of a Court of Law and/or that the corner points mentioned in lines 3, 4 and 5 above were in conformance with the rules of the Michigan Board of Land Surveyors or by a Decree of a Court of Law; established, re-established, monumented, re-monumented, recovered, found as expressed below:

NOTE: Not more than 4 corners, all in the same town and range, may be recorded on this certificate.

A. Description of original monument and accessories and/or subsequent restoration:

Date	Map	Surveyor	Monument
1935	Wit Map	K.C. Surveyor	Concrete Monument
1953	Wit Map	K.C. Surveyor	Concrete Monument
1977	L.C.R.C. 1046	Williams & Works	Concrete Monument
1985	L.C.R.C. 4119	William Byl	Concrete Monument/Set KC Mon
1990	L.C.R.C. 5561	Thomas Starr	KC Monument

P.A. 345 1990 KENT COUNTY,
PEER APPROVED 8/11/94
CHAIRMAN Harry Tuben

The position of this corner was previously approved by the Kent County Remonumentation Peer Group monumented by Jonker William R. Byl on 1/3/85 and was recorded per L.C.R.C. #4119.


B. Description of corner evidence found and/or method applied in restoring or reestablishing corner:

L.C.R.C. #4119	L.C.R.C. #5561
Nail & tag E side 12" Maple N 00° E 33.40'	Nail & remon. tag E side 12" Maple N 00° E 33.21'
Nail & tag W side 15" Maple S 55° W 84.71	Nail & remon. tag W side 15" Maple S 55° W 84.71
Nail & tag E side 15" Maple S 30° W 80.34'	Nail & remon. tag E side 15" Maple S 30° W 80.34'
Nail & tag E side 12" Maple S 10° E 65.89'	Nail & remon. tag E side 12" Maple S 10° E 65.89'
Nail & tag W side 12" Maple S 25° E 83.97'	Nail & remon. tag W side 12" Maple S 25° E 83.97'
"T" Iron S 00° W 33.12'	"T" Iron S 00° W 33.12'
K.C. mon. (S 1/4 corner Sec. 31, 7-12) N 90° E 48.78'	K.C. mon. (S 1/4 corner Sec. 31, 7-12) N 90° E 48.78'

The selected location is accepted by me and is generally accepted by professional surveyors as the best available evidence of the position of the original corner.

C. Description of monument for corner and accessories established to perpetuate locating the position of the corner:

B-1 Standard Kent County Monument
Nail & KC Remon Tag E side 12" Maple N 00° E 33.21'
Nail & KC Remon Tag W side 15" Maple S 55° W 84.71
Nail & KC Remon Tag E side 15" Maple S 30° W 80.34'
Nail & KC Remon Tag E side 12" Maple S 10° E 65.89'
Nail & KC Remon Tag W side 12" Maple S 25° E 83.97'
"T" Iron S 00° W 33.12'
Kent County Monument (S 1/4 corner Sec. 31, 7-12) N 90° E 48.78'

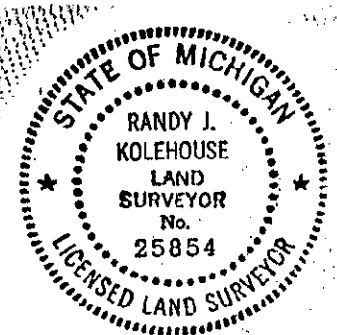

Signed by Randy J. Kolehouse 25854
Surveyor's Michigan License No. _____

Date 11/21/94