

SURVEY & REMONUMENTATION

APR 28 1995

LAND CORNER RECORDATION CERTIFICATE Filing Requirement of Act 74, Mich. P.A. 1970 KENT COUNTY REMONUMENTATION

STATE OF MICHIGAN
COUNTY OF KENT
RECEIVED FOR RECORD
94 DEC -6 AM 8:56

For corners in

COMMISSION

Kent <small>(County)</small>	Located in:	Corner Code #
1. Public Land Survey	T <u>6N</u> R <u>12W</u>	<u>B-2</u>
	T _____ R _____	_____
	T _____ R _____	_____
	T _____ R _____	_____
2. Property Controlling in Section	S _____ T _____ R _____	_____
	S _____ T _____ R _____	_____
3. Miscellaneous Property in Sec.	S _____ T _____ R _____	_____
	S _____ T _____ R _____	_____

Eric Bond
REG. OF DEEDS

7720

Register of Deeds Stamp & File Number

4. Lot No. _____, Recorded Plat _____
5. Private Claims _____

I, Randy Kolehouse, in a field survey on October 10 19 94, do hereby certify that under requirements of P.A. 74 Michigan P.A. of 1970, the corner points mentioned in lines 1 and 2 above were in conformance with regulations and rules therefore as required in the current manual of survey instructions of the United States Department of the Interior, Bureau of Land Management or by a decree of a Court of Law and/or that the corner points mentioned in lines 3, 4 and 5 above were in conformance with the rules of the Michigan Board of Land Surveyors or by a Decree of a Court of Law; established, re-established, monumented, re-monumented, recovered, found as expressed below:

NOTE: Not more than 4 corners, all in the same town and range, may be recorded on this certificate.

	A	B	C	D	E	F	G	H	I	J	K	L	M
2	●		5		4		3		2		1		
3													
4	7		8		9		10		11		12		
5													
6	18		17		16		15		14		13		
7													
8	19		20		21		22		23		24		
9													
10	30		29		28		27		26		25		
11													
12	31		32		33		34		35		36		
13													

A. Description of original monument and accessories and/or subsequent restoration:

B-2 This corner was not originally set by the G.L.O.

1933	Survey Records	Williams & Works	Iron
1993-1972	Survey Records	Williams & Works	3/4" Iron
1972	L.C.R.C. #251	Williams & Works	3/4" Iron
1979	L.C.R.C. #1242	Shangraw	3/4" Iron

B. Description of corner evidence found and/or method applied in restoring or reestablishing corner:


B-2 Found 3/4" iron pipe in the C/L of Riverbend Street 192.6' M/L West of the C/L of Wilson Avenue per Williams & Works survey records 1933-1977. This iron checks L.C.R.C.'s #251 and #1242. Iron is 0.7' North and 11.2' East of the intersection of 1/4 line. Accepted 3/4" iron as Center Section.

P.A. 345 1990 KENT COUNTY
PEER APPROVED 9/22/94
CHAIRMAN Henry Huber

C. Description of monument for corner and accessories established to perpetuate locating the position of the corner:

B-2 Replaced 3/4" iron with Standard 4" x 30" Kent County Monument.

- P.K. nail in NE side White Pine S 20° E 40.30'
- Nail in SW side Maple S 50° E 56.69'
- P.K. nail in W side p. pole North 29.85'
- Nail and K.C. remon. tag in SE side 10" Spruce S 45° W 73.00'
- Nail and K.C. remon. tag in S side 12" Maple N 60° W 99.43'

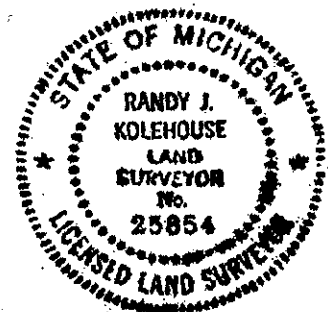

Signed by Randy Kolehouse

Date 12/1/94

Surveyor's Michigan License No. 25854