

SURVEY & REMONUMENTATION

APR 28 1995

Kent County Remonumentation

STATE OF MICHIGAN
COUNTY OF KENT
RECEIVED FOR RECORD

94 NOV 29 AM 9:18

COMMISSION

LAND CORNER RECORDATION CERTIFICATE
Filing Requirement of Act 74, Mich. P.A. 1970

For corners in Kent

(County)	Located In:	Corner Code #
1. Public Land Survey	T <u>6N</u> R <u>12W</u>	B-3
	T _____ R _____	_____
	T _____ R _____	_____
	T _____ R _____	_____
2. Property Controlling in Section	S _____ T _____ R _____	_____
	S _____ T _____ R _____	_____
3. Miscellaneous Property in Sec.	S _____ T _____ R _____	_____
	S _____ T _____ R _____	_____

Tim J. Bond
REG. OF DEEDS

7400

Register of Deeds Stamp & File Number

4. Lot No. _____, Recorded Plat _____
5. Private Claims _____

I, Randy Kolehouse, in a field survey on March 25, 19 94

do hereby certify that under requirements of P.A. 74, Michigan P.A. of 1970, the corner points mentioned in lines 1 and 2 above were in conformance with regulations and rules therefore as required in the current manual of survey instructions of the United States Department of the Interior, Bureau of Land Management or by a decree of a Court of Law and/or that the corner points mentioned in lines 3, 4 and 5 above were in conformance with the rules of the Michigan Board of Land Surveyors or by a Decree of a Court of Law; established, re-established, monumented, re-monumented, recovered, found as expressed below:

NOTE: Not more than 4 corners, all in the same town and range, may be recorded on this certificate.

	A	B	C	D	E	F	G	H	I	J	K	L	M
2	6	5	4	3	2	1							
3													
4	7	8	9	10	11	12							
5													
6	13	17	16	15	14	13							
7													
8	19	20	21	22	23	24							
9													
10	30	29	28	27	26	25							
11													
12	31	32	33	34	35	36							
13													

A. Description of original monument and accessories and/or subsequent restoration:

B-3	1831	G.L.O. Notes	L. Lyon	Set Post
	1944	Wit Map	K.C. Surveyor	Iron
	1972	L.C.R.C. #251	Williams & Works	"T" Iron
	1981	L.C.R.C. #2096	Medema Van Kouten	"T" Iron
	1982	L.C.R.C. #2702	Jonker	Found "T" Iron/Set KC Mon
	1990	L.C.R.C. #5698	Millon	Set KC Mon

P.A. 345 1990 KENT COUNTY
PEER APPROVED 9/22/94
CHAIRMAN *Harry Huber*

The position of this corner was previously approved by the Kent County Remonumentation Peer Group monumented by Robert Jonker on 3/11/82 and was recorded per L.C.R.C. #2702.

B. Description of corner evidence found and/or method applied in restoring or reestablishing corner:

B-3 Found KC Monument per L.C.R.C. 2702 & 5698 as set by Rob Jonker in place of a "T" Iron he found using L.C.R.C. #251 & 2096.

L.C.R.C #2702

L.C.R.C. #5698


Remon. tag on W side 12° Oak NO5'E 44.82'
Spike on NW side 1/4" Maple S35°W 28.37'

Nail & remon. tag in W side 14" Oak N 44.27'
Nail & remon. tag in W side power pole N 30° E 75.97'
Nail & remon. tag in W side 14" Maple S 40° W 28.22'
Nail & remon. tag in E side 12" Oak N 30° W 69.42'

The selected location is accepted by me and is generally accepted by professional surveyors as the best available evidence of the position of the original corner.

C. Description of monument for corner and accessories established to perpetuate locating the position of the corner:

B-3 Standard Kent County Monument
Nail & KC remon. tag in W side 14" Oak N 44.27'
Nail & KC remon. tag in W side power pole N 30° E 75.97'
Nail & KC remon. tag in W side 14" Maple S 40° W 28.22'
Nail & KC remon. tag in E side 12" Oak N 30° W 69.42'

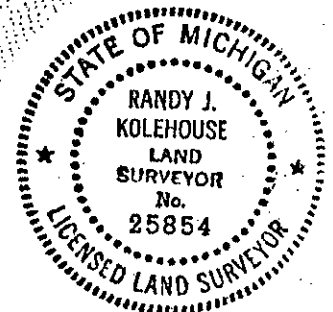

Signed by *Randy J. Kolehouse*
Surveyor's Michigan License No. 25854

Date 11/21/94