

SURVEY & REMONUMENTATION

APR 28 1995

LAND CORNER RECORDATION CERTIFICATE
 Filing Requirement of Act 74, Mich. P.A. 1970
 KENT COUNTY REMONUMENTATION

STATE OF MICHIGAN
 COUNTY OF KENT
 RECEIVED FOR RECORD
 94 DEC -6 AM 8:57

For corners in **COMMISSION**

<u>Kent</u> (County)	Located in:	Corner Code #
1. Public Land Survey	T <u>6N</u> R <u>12W</u>	<u>B-4</u>
	T _____ R _____	_____
	T _____ R _____	_____
	T _____ R _____	_____
2. Property Controlling in Section	S _____ T _____ R _____	_____
	S _____ T _____ R _____	_____
3. Miscellaneous Property in Sec.	S _____ T _____ R _____	_____
	S _____ T _____ R _____	_____

Leif J. Jandt
 REG. OF DEEDS

7721

Register of Deeds Stamp & File Number

4. Lot No. _____, Recorded Plat _____
 5. Private Claims _____

I, Randy Kolehouse, in a field survey on October 10 19 94, do hereby certify that under requirements of P.A. 74 Michigan P.A. of 1970, the corner points mentioned in lines 1 and 2 above were in conformance with regulations and rules therefore as required in the current manual of survey instructions of the United States Department of the interior, Bureau of Land Management or by a decree of a Court of Law and/or that the corner points mentioned in lines 3, 4 and 5 above were in conformance with the rules of the Michigan Board of Land Surveyors or by a Decree of a Court of Law; established, re-established, monumented, re-monumented, recovered, found as expressed below:

NOTE: Not more than 4 corners, all in the same town and range, may be recorded on this certificate.

	A	B	C	D	E	F	G	H	I	J	K	L	M
2	8		5		4		3		2		1		
3													
4	0		3		2		1						
5													
6	18		17		16		15		14		13		
7													
8	10		20		21		22		23		24		
9													
10	30		29		28		27		26		25		
11													
12	31		32		33		34		35		36		
13													

A. Description of original monument and accessories and/or subsequent restoration:

B-4 This corner was not originally set by the G.L.O.

1940-1976	Survey Records	Williams & Works	Iron
1965 ±	Wit. Map	K.C. Surveyor	Iron in Conc. Pavement
1986	L.C.R.C. #4470	Exxel Engineering	Iron in Mon. Box


B. Description of corner evidence found and/or method applied in restoring or reestablishing corner:

B-4 Found monument box (cannot remove cover) 4.6' West of C/L joint of pavement per K.C. Surveyor witnesses and L.C.R.C. #4470. This point checks Williams & Works survey records 1940-1976. Monument box is on the N-S 1/4 line. East 1/4 corner is on East side Grand River and not run. Therefore, no tie is shown to E-W 1/4 line. Accepted C/L of monument box as Center Section.

P.A. 345 1990 KENT COUNTY
 PEER APPROVED 10/12/94
 CHAIRMAN *Henry Kuder*

C. Description of monument for corner and accessories established to perpetuate locating the position of the corner:

- B-4 C/L of Monument Box
 P.K. nail in top guard rail post N 90° E 38.50'
 Nail & K.C. remon. tag in SW side 14" Oak S 40° E 101.36'
 Nail & K.C. remon. tag in SW side 16" Oak S 40° E 101.36'
 Nail & K.C. remon. tag in E side lt. pole N 40° W 96.45'

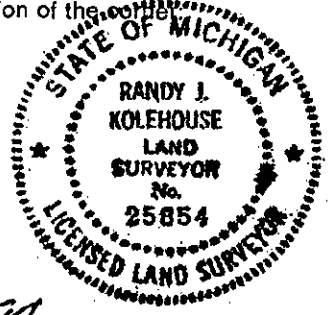

Signed by *Randy J. Kolehouse* Date 12/1/94
 Surveyor's Michigan License No. 25854