

**SURVEY &
REMONUMENTATION**

APR 28 1995

LAND CORNER RECORDATION CERTIFICATE
Filing Requirement of Act 74, Mich. P.A. 1970
KENT COUNTY REMONUMENTATION

For corners in **COMMISSION**

STATE OF MICHIGAN
COUNTY OF KENT
RECEIVED FOR RECORD
94 DEC -6 AM 8:57

Lucy Bond
REG. OF DEEDS


Kent (County)	Located in:	Corner Code #
1. Public Land Survey	T <u>6N</u> R <u>12W</u>	<u>B-6</u>
	T _____ R _____	_____
	T _____ R _____	_____
	T _____ R _____	_____
2. Property Controlling in Section	S _____ T _____ R _____	_____
	S _____ T _____ R _____	_____
3. Miscellaneous Property in Sec.	S _____ T _____ R _____	_____
	S _____ T _____ R _____	_____

7722

Register of Deeds Stamp & File Number

4. Lot No. _____, Recorded Plat _____
5. Private Claims _____

I, Randy Kolehouse, in a field survey on November 3 19 94, do hereby certify that under requirements of P.A. 74 Michigan P.A. of 1970, the corner points mentioned in lines 1 and 2 above were in conformance with regulations and rules therefore as required in the current manual of survey instructions of the United States Department of the Interior, Bureau of Land Management or by a decree of a Court of Law and/or that the corner points mentioned in lines 3, 4 and 5 above were in conformance with the rules of the Michigan Board of Land Surveyors or by a Decree of a Court of Law; established, re-established, monumented, re-monumented, recovered, found as expressed below:

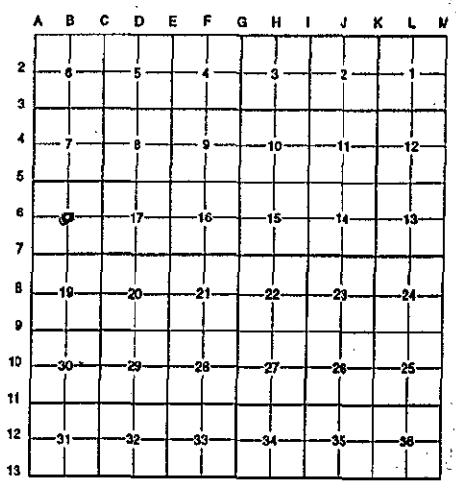

NOTE: Not more than 4 corners, all in the same town and range, may be recorded on this certificate.

A. Description of original monument and accessories and/or subsequent restoration:

B-6 This corner was not originally set by the G.L.O.

1914	Survey Records	Williams & Works	Iron
1940	Wit. Map	K.C. Surveyor	Iron
1975	Survey Records	Exxel Engineering	P.K. & Washer
1975	L.C.R.C. #908	Exxel Engineering	P.K. & Washer

B. Description of corner evidence found and/or method applied in restoring or reestablishing corner:

B-6 Found iron per L.C.R.C. #908. This point checks Williams & Works survey records to 1914 and Exxel Engineering survey information. This iron was originally found by Williams & Works in 1914 and accepted as the Center Section for Canal Street survey. The North 1/4 corner falls on the North side of the Grand River and therefore does not control the E-W position of this corner. The iron is 48.7' West of a line between the N & S 1/4 corners of Section and 0.9' North of the E-W 1/4 line. Because of the long history of use of this iron accepted for the Center of Section.

Checked dist. to S 1/4 corner 2658.1' (WW 1914 = 2657.7')
Checked dist. to E 1/4 corner 2562.3' (WW 1935 = 2562.8')


P.A. 345 1990 KENT COUNTY

PEER APPROVED 4/17/94
Harry Huber

C. Description of monument for corner and accessories established to perpetuate locating the position of the corner:

B-6 Set Standard K.C. Monument

SE corner of brick bldg. S 45° E 55.56'
NE corner of brick bldg. N 40° W 63.69"
SW corner of brick bldg. North 29.51'
SE corner of brick bldg. N 40° E 38.40'
Nail & K.C. remon. tag in NE side p. pole S 20° W 73.17

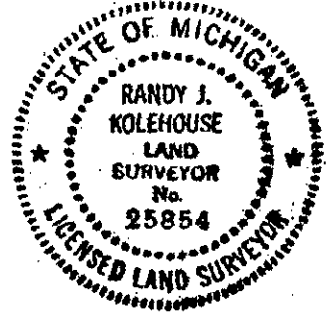

Signed by *Randy Kolehouse*
Surveyor's Michigan License No. 25854

Date 12/1/94