

SURVEY & REMONUMENTATION

Kent County Remonumentation

STATE OF MICHIGAN
COUNTY OF KENT
RECEIVED FOR RECORD

APR 28 1995

LAND CORNER RECORDATION CERTIFICATE Filing Requirement of Act 74, Mich. P.A. 1970

94 NOV 29 AM 9:18

For corner **COMMISSION**
Kent
(County)

Located In: Corner Code =#

- | | | |
|------------------------------------|--------------------------|------------|
| 1. Public Land Survey | T <u>6N</u> R <u>12W</u> | <u>B-7</u> |
| | T _____ R _____ | _____ |
| | T _____ R _____ | _____ |
| | T _____ R _____ | _____ |
| 2. Property Controlling in Section | S _____ T _____ R _____ | _____ |
| | S _____ T _____ R _____ | _____ |
| 3. Miscellaneous Property in Sec. | S _____ T _____ R _____ | _____ |
| | S _____ T _____ R _____ | _____ |

Lee J. Bond
REG. OF DEEDS

7401

Register of Deeds Stamp & File Number

4. Lot No. _____, Recorded Plat _____
5. Private Claims _____

	A	B	C	D	E	F	G	H	I	J	K	L	M
2	6		5		4		3		2				
3													
4	7		8		9		10		11		12		
5													
6	18		17		16		15		14		13		
7													
8	19		20		21		22		23		24		
9													
10	30		29		28		27		26		25		
11													
12	31		32		33		34		35		36		
13													

I, Randy Kolehouse, in a field survey on March 25, 19 94, do hereby certify that under requirements of P.A. 74, Michigan P.A. of 1970, the corner points mentioned in lines 1 and 2 above were in conformance with regulations and rules therefore as required in the current manual of survey instructions of the United States Department of the Interior, Bureau of Land Management or by a decree of a Court of Law and/or that the corner points mentioned in lines 3, 4 and 5 above were in conformance with the rules of the Michigan Board of Land Surveyors or by a Decree of a Court of Law; established, re-established, monumented, re-monumented, recovered, found as expressed below:

NOTE: Not more than 4 corners, all in the same town and range, may be recorded on this certificate.

- | | | | |
|--|---------------|-------------------|---------------------------------------|
| A. Description of original monument and accessories and/or subsequent restoration: | | | |
| 1831 | G.L.O. Notes | L. Lyon | Set Post |
| 1932-45 | Survey Notes | Williams & Works | Iron |
| 1965 | Wit Map | KC Surveyor | Iron |
| 1965 | Wit Map | MDSH | Iron |
| 1972 | L.C.R.C. 436 | Medema Van Kooten | Iron |
| 1977 | Survey Notes | Exxel Engineering | Iron in M.B. |
| 1984 | L.C.R.C. 3929 | Rosema | Found Iron in M.B.
Set KC Monument |

P.A. 345 1990 KENT COUNTY

PEER APPROVED 7/28/94
CHAIRMAN Harry Kuper

This corner was originally approved by the Kent County Remonumentation Peer Group and monumented by Maurice J. Bosema on 10/1/84 and was recorded per L.C.R.C. #3929.

- B. Description of corner evidence found and/or method applied in restoring or reestablishing corner:


B-7 Found KC Monument in Canal Ave. running N-S and 36th running E-W per L.C.R.C. #3929 as set by Maurice Rosema in place of an iron in monument box he found using Williams & Works survey notes & L.C.R.C. 436.

L.C.R.C. #3929

- SW corner concrete fndn. of house N 65° E 96.38'
- SE corner of brick house N 45° W 116.61'
- NE corner of brick house S 55° W 88.15'
- SW corner concrete block fndn. of house S 50° E 77.95'

The selected location is accepted by me and is generally accepted by professional surveyors as the best available evidence of the position of the original corner to perpetuate locating the position of the corner:

- C. Description of monument and its position to perpetuate locating the position of the corner:
- B-7 Standard Kent County Monument
- SW corner concrete fndn. of house N 65° E 96.38'
 - SE corner of brick house N 45° W 116.61'
 - NE corner of brick house S 55° W 88.15'
 - SW corner concrete block fndn. of house S 50° E 77.95'

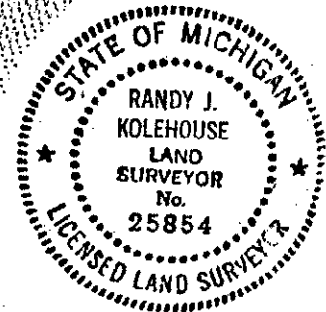

Signed by Randy J. Kolehouse

Date 11/21/94

Surveyor's Michigan License No. 25854