

SURVEY & REMONUMENTATION

APR 28 1995

COMMISSION

LAND CORNER RECORDATION CERTIFICATE Filing Requirement of Act 74, Mich. P.A. 1970 KENT COUNTY REMONUMENTATION

For corners in

Kent (County)	Located in:	Corner Code #	
1. Public Land Survey	T <u>6N</u> R <u>12W</u>	<u>B-8</u>	
	T _____ R _____	_____	
	T _____ R _____	_____	
	T _____ R _____	_____	
2. Property Controlling in Section	S _____ T _____ R _____	_____	
	S _____ T _____ R _____	_____	
3. Miscellaneous Property in Sec.	S _____ T _____ R _____	_____	
	S _____ T _____ R _____	_____	

4. Lot No. _____, Recorded Plat _____
5. Private Claims _____

STATE OF MICHIGAN
COUNTY OF KENT
RECEIVED FOR RECORD
94 DEC -6 AM 8:57

Lucy Bond
REG. OF DEEDS

7723

Register of Deeds Stamp & File Number

I, Randy Kolehouse, in a field survey on October 8 19 94, do hereby certify that under requirements of P.A. 74 Michigan P.A. of 1970, the corner points mentioned in lines 1 and 2 above were in conformance with regulations and rules therefore as required in the current manual of survey instructions of the United States Department of the interior, Bureau of Land Management or by a decree of a Court of Law and/or that the corner points mentioned in lines 3, 4 and 5 above were in conformance with the rules of the Michigan Board of Land Surveyors or by a Decree of a Court of Law; established, re-established, monumented, re-monumented, recovered, found as expressed below:


NOTE: Not more than 4 corners, all in the same town and range, may be recorded on this certificate.

A. Description of original monument and accessories and/or subsequent restoration:

B-8 This corner was not originally set by the G.L.O.

1945-1977	Survey Notes	Williams & Works	Iron
1972	L.C.R.C. #177	Williams & Works	1/2" Iron
1985	L.C.R.C. #4205	M. Rosema	P.K. Nail

P.A. 345 1990 KENT COUNTY,
PEER APPROVED 7/28/94
Harry Huber

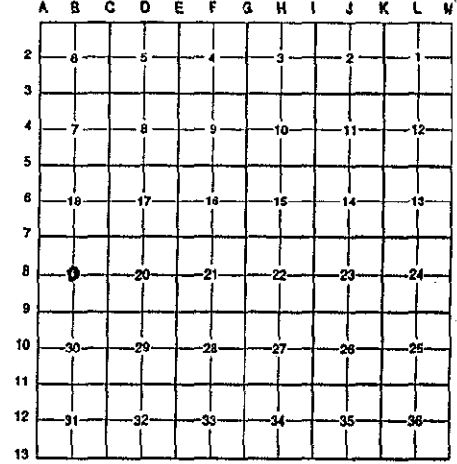


B. Description of corner evidence found and/or method applied in restoring or reestablishing corner:

B-8 Found P.K. nail in C/L X of 40th Street E-W and Canal Avenue N-S which checks witnesses L.C.R.C.'s #177 and #4205. Also checks Williams & Works survey records of 1945-1954. Said point is 1.8' South and 3.3' West of the intersection of 1/4 lines. Accepted P.K. for Center Section.

- Description of monument for corner and accessories established to perpetuate locating the position of the corner:

-8 Replace P.K. with Standard 4" x 30" Kent County Monument (Harrison).

- NE corner fnd. of hse. S 87° W 64.03'
- SW corner fnd. of hse. N 52° E 80.42'
- NW corner brick on hse. S 34° E 100.65'
- Nail & K.C. remon. tag in p. pole N 25° W 45.79'
- Nail & K.C. remon. tag in p. pole N 33° E 45.40'

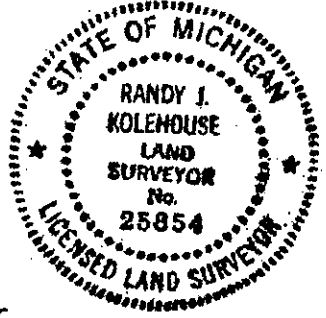

Prepared by *Randy J. Kolehouse*
Surveyor's Michigan License No. 25854

Date 12/1/94