

# SURVEY & REMONUMENTATION

Kent County Remonumentation

APR 28 1995

COMMISSION

LAND CORNER RECORDATION CERTIFICATE  
Filing Requirement of Act 74, Mich. P.A. 1970

STATE OF MICHIGAN  
COUNTY OF KENT  
RECEIVED FOR RECORD

94 NOV 29 AM 9:18

*Lucy Bond*  
REG. OF DEEDS

For corners in  
Kent

(County)	Located In:	Corner Code #
1. Public Land Survey	T <u>6N</u> R <u>12W</u>	<u>B-9</u>
	T _____ R _____	_____
	T _____ R _____	_____
	T _____ R _____	_____
2. Property Controlling in Section	S _____ T _____ R _____	_____
	S _____ T _____ R _____	_____
3. Miscellaneous Property in Sec.	S _____ T _____ R _____	_____
	S _____ T _____ R _____	_____
4. Lot No. _____, Recorded Plat _____		
5. Private Claims _____		

7402

Register of Deeds Stamp & File Number

	A	B	C	D	E	F	G	H	I	J	K	L	M
2	6	5	4	3	2	1							
3													
4	7	8	9	10	11	12							
5													
6	18	17	16	15	14	13							
7													
8	19	20	21	22	23	24							
9													
10	30	29	28	27	26	25							
11													
12	31	32	33	34	35	36							
13													

I, Randy Kolehouse, in a field survey on March 25, 1994, do hereby certify that under requirements of P.A. 74, Michigan P.A. of 1970, the corner points mentioned in lines 1 and 2 above were in conformance with regulations and rules therefore as required in the current manual of survey instructions of the United States Department of the Interior, Bureau of Land Management or by a decree of a Court of Law and/or that the corner points mentioned in lines 3, 4 and 5 above were in conformance with the rules of the Michigan Board of Land Surveyors or by a Decree of a Court of Law; established, re-established, monumented, re-monumented, recovered, found as expressed below:

**NOTE: Not more than 4 corners, all in the same town and range, may be recorded on this certificate.**

A. Description of original monument and accessories and/or subsequent restoration:

B-9	1831	G.L.O. Notes	L. Lyon	Set Post	P.A. 345 1990 KENT COUNTY
	1965	Wit Map	MDOT	Iron	PEER APPROVED <u>7/28/94</u>
	1971	L.C.R.C. 177	Williams & Works	3/4" Iron	CHAIRMAN <u>[Signature]</u>
	1974	L.C.R.C. 782	Englert	1" Pipe	
	1981	L.C.R.C. 2349	Exxel	Fnd. 1/2" Iron/Set KC Mon.	

This corner was originally approved by the Kent County Remonumentation Peer Group and monumented by Exxel Engineering, Inc., on 9/24/81 and was recorded per L.C.R.C. #2349.

B. Description of corner evidence found and/or method applied in restoring or reestablishing corner:

B-9 Found KC Monument per L.C.R.C. 2349 wits. This point was established by Exxel Engineering using survey notes and witnesses from Exxel Engineering survey records.

L.C.R.C. #2349


PK in W'y side p. pole N 33° W 97.74'  
"X" cut in rim of Mich. Con. Gas Co. M.H. S 15° E 70.46' (NW'y side of rim)  
Chiseled "X" in top of conc. curb S 45° W 86.78'  
C/L san. M.H. due East 16.41'  
"+ " cut in top of conc. curb N 0° E 79.30'

C. Description of monument for corner and accessories established to perpetuate locating the position of the corner:

B-9 The selected location is accepted by me and is generally accepted by professional surveyors as the best available evidence of the position of the original corner.

Standard Kent County Monument

PK in W'y side p. pole N 33° W 97.74'  
"X" cut in rim of Mich. Con. Gas Co. M.H. S 15° E 70.46' (NW'y side of rim)  
Chiseled "X" in top of conc. curb S 45° W 86.78'  
C/L san. M.H. due East 16.41'  
"+ " cut in top of conc. curb N 0° E 79.30'

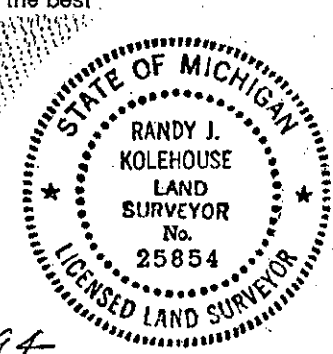

Signed by Randy J. Kolehouse  
Surveyor's Michigan License No. 25854

Date 11/21/94