

SURVEY & REMONUMENTATION

Kent County Remonumentation

STATE OF MICHIGAN
COUNTY OF KENT
RECEIVED FOR RECORD

APR 28 1995

LAND CORNER RECORDATION CERTIFICATE
Filing Requirement of Act 74, Mich. P.A. 1970

94 NOV 29 AM 9:18

For corners in
Kent

COMMISSION

Lucy Bond
REG. OF DEEDS

For corners in Kent (County)	Located In:	Corner Code #
1. Public Land Survey	T <u>6N</u> R <u>12W</u>	<u>B-11</u>
	T _____ R _____	_____
	T _____ R _____	_____
	T _____ R _____	_____
2. Property Controlling in Section	S _____ T _____ R _____	_____
	S _____ T _____ R _____	_____
3. Miscellaneous Property in Sec.	S _____ T _____ R _____	_____
	S _____ T _____ R _____	_____

7403

Register of Deeds Stamp & File Number

4. Lot No. _____, Recorded Plat _____
5. Private Claims _____

	A	B	C	D	E	F	G	H	I	J	K	L	M
2	6	5	4	3	2	1							
3													
4	7	8	9	10	11	12							
5													
6	18	17	16	15	14	13							
7													
8	19	20	21	22	23	24							
9													
10	30	29	28	27	26	25							
11	31	32	33	34	35	36							
12													
13													

I, Randy Kolehouse, in a field survey on March 24, 19 94, do hereby certify that under requirements of P.A. 74, Michigan P.A. of 1970, the corner points mentioned in lines 1 and 2 above were in conformance with regulations and rules therefore as required in the current manual of survey instructions of the United States Department of the Interior, Bureau of Land Management or by a decree of a Court of Law and/or that the corner points mentioned in lines 3, 4 and 5 above were in conformance with the rules of the Michigan Board of Land Surveyors or by a Decree of a Court of Law; established, re-established, monumented, re-monumented, recovered, found as expressed below:

NOTE: Not more than 4 corners, all in the same town and range, may be recorded on this certificate.

A. Description of original monument and accessories and/or subsequent restoration:

B-11	1831	G.L.O. Notes	L. Lyon	Set Post	P.A. 345 1990 KENT COUNTY
	1965	Wit Map	KC Surveyor	"T" Iron	PEER APPROVED 7/28/94
	1972	L.C.R.C. 242	Williams & Works	"T" Iron	CHAIRMAN <i>Randy Kolehouse</i>
	1981	L.C.R.C. 1957	Exxel Eng.	Found "T" Iron	
				Set KC Mon	

This corner was originally approved by the Kent County Remonumentation Peer Group and monumented by Exxel Engineering, Inc., on 8/18/81 and was recorded per L.C.R.C. #1957.

B. Description of corner evidence found and/or method applied in restoring or reestablishing corner:

B-11 Found KC Monument per L.C.R.C. 1957 at center line Canal Ave. N & SW & 56th St. East as set by Exxel Eng. in place of a "T" Iron they found using KC Surveyor's records and L.C.R.C. 242.


L.C.R.C. #1957

NE cor. hse. S 51° E 161.27'
SE'ly cor. hse. (brick corner) N 53° E 135.67'
SE cor. garage N 57° W 126.04'

The selected location is accepted by me and is generally accepted by professional surveyors as the best available evidence of the position of the original corner.

C. Description of monument for corner and accessories established to perpetuate locating the position of the corner:

B-11 Standard Kent County Monument
NE cor. hse. S 51° E 161.27'
SE'ly cor. hse. (brick corner) N 53° E 135.67'
SE cor. garage N 57° W 126.04'
Nail & K.C. remon. tag in N side clump 14" Oaks S 87° W 109.07'
Nail & K.C. remon. tag in W side 4-18" Cherry S 15° E 90.10'
P.K. in S side p. pole S 60° W 60.53'

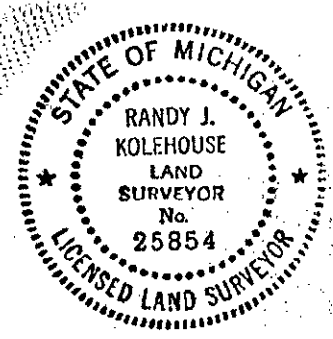

Signed by *Randy J. Kolehouse*
Surveyor's Michigan License No. 25854

Date 11/21/94