

SURVEY & REMONUMENTATION

Kent County Remonumentation

STATE OF MICHIGAN
COUNTY OF KENT
RECEIVED FOR RECORD

APR 28 1995

LAND CORNER RECORDATION CERTIFICATE
Filing Requirement of Act 74, Mich. P.A. 1970

94 NOV 29 AM 9:18

For corners in Kent

COMMISSION

Tim J. Bond
REG. OF DEEDS

For corners in Kent (County)	Located In:	Corner Code --#
1. Public Land Survey	T <u>6N</u> R <u>12W</u>	B-13
	T _____ R _____	_____
	T _____ R _____	_____
	T _____ R _____	_____
2. Property Controlling in Section	S _____ T _____ R _____	_____
	S _____ T _____ R _____	_____
3. Miscellaneous Property in Sec.	S _____ T _____ R _____	_____
	S _____ T _____ R _____	_____

7404

Register of Deeds Stamp & File Number

4. Lot No. _____, Recorded Plat _____
5. Private Claims _____

	A	B	C	D	E	F	G	H	I	J	K	L	M
2	6	5	4	3	2	1							
3													
4	7	8	9	10	11	12							
5													
6	13	17	16	15	14	13							
7													
8	19	20	21	22	23	24							
9													
10	30	29	28	27	26	25							
11													
12	31	32	33	34	35	36							
13													

I, Randy Kolehouse, in a field survey on June 20, 1994, do hereby certify that under requirements of P.A. 74, Michigan P.A. of 1970, the corner points mentioned in lines 1 and 2 above were in conformance with regulations and rules therefore as required in the current manual of survey instructions of the United States Department of the Interior, Bureau of Land Management or by a decree of a Court of Law and/or that the corner points mentioned in lines 3, 4 and 5 above were in conformance with the rules of the Michigan Board of Land Surveyors or by a Decree of a Court of Law; established, re-established, monumented, re-monumented, recovered, found as expressed below:

NOTE: Not more than 4 corners, all in the same town and range, may be recorded on this certificate.

A. Description of original monument and accessories and/or subsequent restoration:

B-13	1831	G.L.O. Notes	L. Lyon	Set Post
	??	Wit Map	KC Surveyor	3/4" Iron
	1982	L.C.R.C. 2936	Exxel Eng.	3/4" Iron
	1982	L.C.R.C. 3181	Jonker	Found 3/4" Iron/Set K.C. Mon.

P.A. 345 1990 KENT COUNTY
PEER APPROVED 9/22/94
CHAIRMAN *Harry Harper*

The position of this corner was previously approved by the Kent County Remonumentation Peer Group monumented by Jonker Land Surveys on 11/19/82 and was recorded per L.C.R.C. #3181.

B. Description of corner evidence found and/or method applied in restoring or reestablishing corner:

B-13 Found KC Monument per L.C.R.C. 3181 as set by Rub Jonker in place of a 3/4" Iron he found using KC Surveyor Records and L.C.R.C. 2936.


L.C.R.C. #3181

- Remon. tag on N side 10" Ash S 50° W 7.55'
- Remon. tag on E side 14" Ash N 45° W 9.15'
- Remon. tag on NW side 40" Oak N 10° E 57.15'
- Remon. tag on N side 8" Oak N 65° E 36.08'
- In N-S fence and tree line

The selected location is accepted by me and is generally accepted by professional surveyors as the best available evidence of the position of the original corner.

C. Description of monument for corner and accessories established to perpetuate locating the position of the corner:

B-13 Standard Kent County Monument
Nail & K.C. remon. tag on N side 10" Ash S 50° W 7.55'
Nail & K.C. remon. tag on E side 14" Ash N 45° W 9.15'
Nail & K.C. remon. tag on NW side 40" Oak N 10° E 57.15'
Nail & K.C. remon. tag on N side 8" Oak N 65° E 36.08'
In N-S fence and tree line

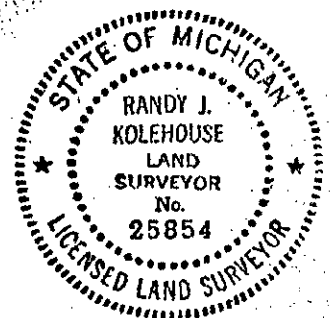

Signed by *Randy J. Kolehouse*

Date 11/21/94

Surveyor's Michigan License No. 25854