

SURVEY & REMONUMENTATION

Kent County Remonumentation

STATE OF MICHIGAN
COUNTY OF KENT
RECEIVED FOR RECORD

APR 28 1995

LAND CORNER RECORDATION CERTIFICATE
Filing Requirement of Act 74, Mich. P.A. 1970

94 NOV 29 AM 9:18

For corners in Kent
COMMISSION
(County)

Located In: Corner Code #/

W. J. Bond
REG. OF DEEDS

- | | | |
|------------------------------------|--------------------------|------------|
| 1. Public Land Survey | T <u>6N</u> R <u>12W</u> | <u>C-8</u> |
| | T _____ R _____ | _____ |
| | T _____ R _____ | _____ |
| | T _____ R _____ | _____ |
| 2. Property Controlling in Section | S _____ T _____ R _____ | _____ |
| | S _____ T _____ R _____ | _____ |
| 3. Miscellaneous Property in Sec. | S _____ T _____ R _____ | _____ |
| | S _____ T _____ R _____ | _____ |

7411

Register of Deeds Stamp & File Number

4. Lot No. _____, Recorded Plat _____
5. Private Claims _____

	A	B	C	D	E	F	G	H	I	J	K	L	M
2	6	5	4	3	2	1							
3													
4	7	8	9	10	11	12							
5													
6	18	17	16	15	14	13							
7													
8	19	20	21	22	23	24							
9													
10	30	29	28	27	26	25							
11													
12	31	32	33	34	35	36							
13													

I, Randy Kolehouse, in a field survey on March 29, 1994, do hereby certify that under requirements of P.A. 74, Michigan P.A. of 1970, the corner points mentioned in lines 1 and 2 above were in conformance with regulations and rules therefore as required in the current manual of survey instructions of the United States Department of the Interior, Bureau of Land Management or by a decree of a Court of Law and/or that the corner points mentioned in lines 3, 4 and 5 above were in conformance with the rules of the Michigan Board of Land Surveyors or by a Decree of a Court of Law; established, re-established, monumented, re-monumented, recovered, found as expressed below:

NOTE: Not more than 4 corners, all in the same town and range, may be recorded on this certificate.

A. Description of original monument and accessories and/or subsequent restoration:

C-8	1831	G.L.O. Notes	L. Lyon	Set Post
	1938	Wit. Map	K.C. Surveyor	Iron
	1965	Wit. Map	K.C. Surveyor	Iron
	1974	L.C.R.C. #695	Williams & Works	On M.H.
	1982	L.C.R.C. #3032	Jonker	On M.H.

P.A. 345 1990 KENT COUNTY

PEER APPROVED 7/28/94

CHAIRMAN *Randy Kolehouse*

This corner was originally approved by the Kent County Remonumentation Peer Group and monumented by Jonker Land Surveys on 8/9/82 and was recorded per L.C.R.C. #3032.

B. Description of corner evidence found and/or method applied in restoring or reestablishing corner:

C-8 Set point on M.H. at C/L Intersection of Wilson Avenue running N-S and 40th Street running E-W using chiseled cuts on rim. Checks L.C.R.C. #3032 which set point using witnesses from K.C. Surveyor's wit. map and L.C.R.C. #695.


L.C.R.C. #3032

Found intersection of chisel marks on rim of M.H.	C/L M.H. N 60° W 19.08'
"+" cut on NE rim M.H. S 45° W 59.35'	C/L M.H. North 54.95'
C/L top hydrant N 55° E 37.28'	C/L M.H. NNE 0.6'
K.C. remon. tag on NE side p. pole N 45° W 44.72'	

The selected location is accepted by me and is generally accepted by professional surveyors as the best available evidence of the position of the original corner.

C. Description of monument for corner and accessories established to perpetuate locating the position of the corner:

C-8 Intersection of chisel marks on rim of M.H.
 "+" cut on NE rim M.H. S 45° W 59.35'
 C/L top hydrant N 55° E 37.28'
 Nail & K.C. remon. tag on NE side p. pole N 45° W 44.72'
 C/L M.H. N 60° W 19.08'
 C/L M.H. North 54.95'
 C/L M.H. NNE 0.6'

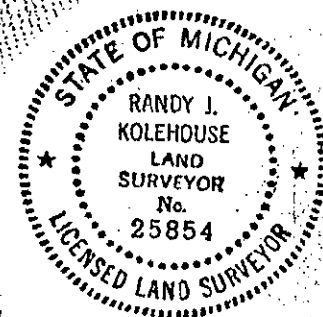

Signed by Randy J. Kolehouse

Date 11/21/94

Surveyor's Michigan License No. 25854