

# SURVEY & REMONUMENTATION

Kent County Remonumentation

STATE OF MICHIGAN  
COUNTY OF KENT  
RECEIVED FOR RECORD

APR 28 1995

LAND CORNER RECORDATION CERTIFICATE  
Filing Requirement of Act 74, Mich. P.A. 1970

94 NOV 29 AM 9:18

For corners in **COMMISSION**  
Kent

*Lee J. Bond*  
REG. OF DEEDS

(County)	Located In:	Corner Code #/
1. Public Land Survey	T <u>6N</u> R <u>12W</u>	<u>C-11</u>
	T _____ R _____	_____
	T _____ R _____	_____
	T _____ R _____	_____
2. Property Controlling in Section	S _____ T _____ R _____	_____
	S _____ T _____ R _____	_____
3. Miscellaneous Property in Sec.	S _____ T _____ R _____	_____
	S _____ T _____ R _____	_____
4. Lot No. _____, Recorded Plat _____		
5. Private Claims _____		

**7414**  
Register of Deeds Stamp & File Number

	A	B	C	D	E	F	G	H	I	J	K	L	M
2	6	5	4	3	2	1							
3													
4	7	8	9	10	11	12							
5													
6	13	17	16	15	14	13							
7													
8	19	20	21	22	23	24							
9													
10	30	29	28	27	26	25							
11													
12	31	32	33	34	35	36							
13													

I, Randy Kolehouse, in a field survey on March 31, 1994, do hereby certify that under requirements of P.A. 74, Michigan P.A. of 1970, the corner points mentioned in lines 1 and 2 above were in conformance with regulations and rules therefore as required in the current manual of survey instructions of the United States Department of the Interior, Bureau of Land Management or by a decree of a Court of Law and/or that the corner points mentioned in lines 3, 4 and 5 above were in conformance with the rules of the Michigan Board of Land Surveyors or by a Decree of a Court of Law; established, re-established, monumented, re-monumented, recovered, found as expressed below:

**NOTE: Not more than 4 corners, all in the same town and range, may be recorded on this certificate.**

**A. Description of original monument and accessories and/or subsequent restoration:**

C-11	1831	G.L.O. Notes	L. Lyon	Set Post
	1944	Wit. Map	K.C. Surveyor	Iron & Stone
	1972	L.C.R.C. #242	Williams & Works	1" Iron in Mon. Box
	1981	L.C.R.C. #1962	Exxel Engineering	1" Iron

This corner was originally approved by the Kent County Remonumentation Peer Group and monumented by Exxel Engineering, Inc., on 8/31/81 and was recorded per L.C.R.C. #1962.

**B. Description of corner evidence found and/or method applied in restoring or reestablishing corner:**

C-11 Found K.C. Monument at approximately the C/L of Wilson Avenue running N-S and 52nd Avenue running E-W which was set by Exxel Engineering in place of a 1" iron they found and checked using L.C.R.C. #242.

L.C.R.C. #1962


- S'y cor. of hse. N 61° E 169.23'
- Top of C/L hydrant N 54° E 57.03'
- SE cor. concrete fndn. of shed N 25° W 185.47'
- "X" in top of concrete headwall S 27° W 68.98'
- C/L "X" of E, W, N, S roads North 1.5' ±

The selected location is accepted by me and is generally accepted by professional surveyors as the best available evidence of the position of the original corner.

**C. Description of monument for corner and accessories established to perpetuate locating the position of the corner:**

- C-11 Standard Kent County Monument
- S'y cor. of hse. N 61° E 169.23'
- Top of C/L hydrant N 54° E 57.03'
- SE cor. concrete fndn. of shed N 25° W 185.47'
- "X" in top of concrete headwall S 27° W 68.98'
- Nail & K.C. remon. tag in SW side p. pole S 45° E 41.43'
- Nail & K.C. remon. tag in SW side p. pole N 45° W 42.69'

P.A. 345 1900 KENT COUNTY  
PEER APPROVED 7/28/94  
CHAIRMAN Harry Huber

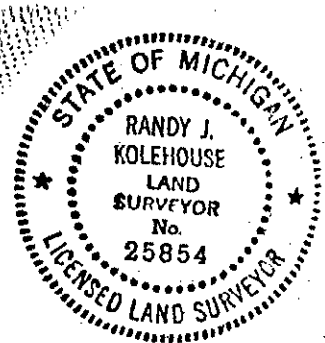

igned by Randy J. Kolehouse  
urveyor's Michigan License No. 25854

Date 11/21/94